

U.S. PUBLIC LAND SURVEY MONUMENT RECORD


NOTE: This form is intended and designed to fulfill all requirements of Wisconsin Administrative Code, Chapter A-E 7 .08 U.S. Public Land Survey Monument Record (3)(a)(b)(c)(d)(e)(f)(g)(h)(i). An additional sheet may be added if necessary to conform with said requirements.

(a) Corner location: Township 36 North
 Range 9 East/West

Town of Pelican

County of Oneida

M.C.
 South side
 of River

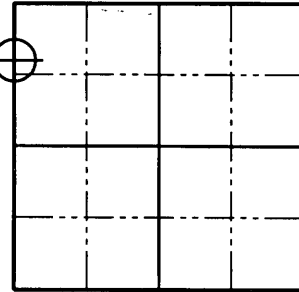

Section 22



(b)(f)(g)(h) Description of monument found at this corner and if it was accepted, state all evidence (material, testimonial, occupation, plats, records, other monuments) used as a basis for accepting. If not accepted or if nothing was found, state evidence used as a basis for establishing location. If reestablished through lost corner proportionate methods, indicate all monuments, distances and directions used to establish. Indicate type of monument found or set and sign post.

July/August 1863 – William E. Daugherty set Meander Post on right bank of Pelican River; BT's: 12" Maple, S17°E, 34 lks.

March 21, 1910 – D.H. Vaughan ran North from W 1/4 Post 40.90 Chains and fell 1.29 Chains East of Northwest Corner. He set Meander Corner on right bank of the Pelican River at 29.55 Chains North of W 1/4 Post; BT's: 12" Maple, N20°E, 2 lks.; 12" Hemlock, S11°W, 16-1/2 lks.


November 8, 2006 – Todd Loftus set a 1" iron pipe for the Meander Corner 5' South of the shore of the Pelican River.

December, 13 2006 – Matthew E. Høglund found the 1" iron pipe set by Loftus. We surveyed to the Northwest Section corner and West 1/4 Corner of Section 21 and found that the 1" iron pipe was set 1.35' West of the Section line. We set an Oneida County Aluminum Monument on the Section line 29'± South of the Pelican River and witnessed the corner as shown on Sheet 2 hereof.

(c)(d)(e) Plan view of corner with ties to at least 4 witness monuments. If in disagreement with previously established corner, show the distances between the two corners and also indicate the ties to the disputed corner.

See Sheet 2 hereof

REGISTER OF DEEDS OFFICE
 ONEIDA COUNTY, WIS.

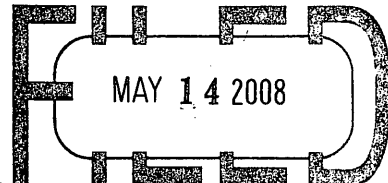


(i) I, Matthew E. Høglund, certify that the corner location on this record was determined by me under my direction and control At _____ O'Clock _____ M and that this U.S. Public Land Survey Monument is correct and complete to the best of my knowledge and belief.

THOMAS H. LEIGHTON
 REGISTER OF DEEDS

Signature

Date

5/13/2008

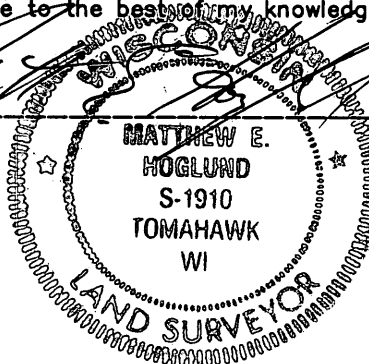

3609213200

Sheet 1 of 2





Index No. N/0-13


U.S. PUBLIC LAND SURVEY MONUMENT RECORD



All bearings are referenced to the West line of the NW 1/4 of Section 22 recorded as bearing N00°31'39"W on the Oneida County Coordinate System.

Legend

-  Found Oneida County Aluminum Monument
-  Set Oneida County Aluminum Monument
-  Found 3/8" Iron Rod
-  Found 1" Iron Pipe Corner set per Loftus

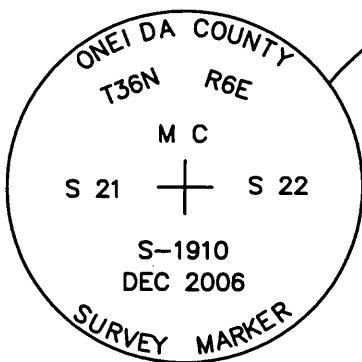

Note

All trees were blazed with 60 P nail set in side of tree and a BT Sign placed on face of tree.

GRAPHIC SCALE



(IN FEET)

