


U.S. PUBLIC LAND SURVEY MONUMENT RECORD

NOTE: This form is intended and designed to fulfill all requirements of Wisconsin Administrative Code, Chapter A-E 7.08 U.S. Public Land Survey Monument Record (3)(a)(b)(c)(d)(e)(f)(g)(h)(i). An additional sheet may be added if necessary to conform with said requirements.

(a) Corner location: **Township 36 North**
Range 9 East

Town of Pelican
Oneida County, Wisconsin

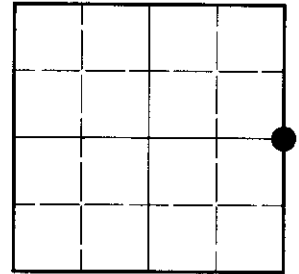

Section 22


(b)(f)(g)(h) Description of monument found at this corner and if it was accepted, state all evidence (material, testimonial, occupational, plats, records, other monuments) used as a basis for accepting. If not accepted or if nothing was found, state evidence used as basis for establishing location. If reestablished through lost corner proportionate methods, indicate all monuments, distances and directions used to establish. Indicate type of monument found or set and sign post.

July-August, 1863: William Daugherty, U.S. Deputy Surveyor, set a wood post witnessed by a Y.Pine 20" S14°E, 41 lks. and a Birch 6" N28°W, 10 lks.


November, 1973: William Scherer, Registered Land Surveyor, found a brass capped iron pipe witnessed by a Balsam 14" N56°E, 14.15 feet; an Aspen 4" S26°E, 12.45 feet and an Aspen 6" N59°W, 14.95 feet.

January 9, 1997: I found and accepted a 2" dia. iron pipe with a 3" dia. aluminum cap 16" above grade and marked as shown below. A 1" dia. iron pipe bears Southwest, 0.35 feet. I established accessories as shown below and set a plastic sign post North, 1 foot.

(c)(d)(e) Plan view of corner with ties to at least 4 witness monuments. If in disagreement with previously established corner, show the distances between the two corners and also indicate the ties to the disputed corner.

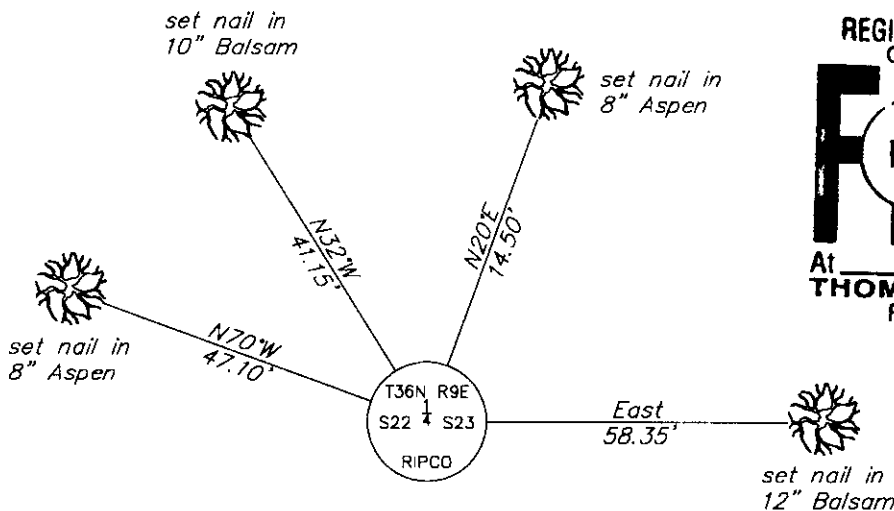

(NOT TO SCALE)

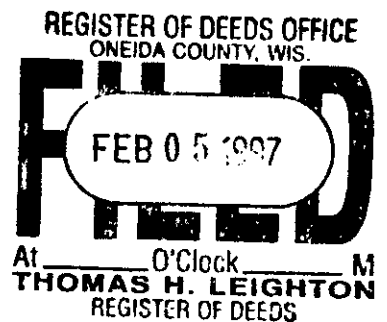

(i) I, Devon Vanden Heuvel, Registered Land Surveyor #S-1795, hereby certify that the corner location on this record was determined by me or under my direction and control and that this U.S. Public Land Survey Monument Record is correct and complete to the best of my knowledge and belief.

Devon Vanden Heuvel
 Signature

1-10-97
 Date



Index No. P-17

3609222000

US PUBLIC LAND SURVEY MONUMENT RECORD


Per Wis. Admin. Code § A-E 7.08, a U.S. public land survey monument record shall be prepared and filed with the county survey records as part of any land survey within 60 days of setting or accepting the corner, which includes or requires the perpetuation, restoration, or use of a U.S. public land survey corner and when any of the situations in Wis. Admin. Code § A-E 7.08(1)(a), 7.08(1)(b) or 7.08(1)(c) arise.

3(a) Corner location:

Found 3" aluminum monument on 2" iron pipe, as noted by Vanden Heuvel in 1997.
East 1/4 Corner
Section 22
Township 36 North
Range 9 East
4th Principal Meridian
Town of Pelican
Oneida Co., WI

WISCRS:
N: 148767.83
E: 281083.87
Datum: NAD 83 (2011)
GNSS Control: WISCRS Network
GNSS Method: RTK-Direct
Verification Method: 1
Published Coordinates:
N: 148767.77
E: 281083.88

The coordinate value, if shown, has been verified by at least one of the following methods: 1) comparison to a previously GNSS determined published value; 2) The value is the average of two or more GNSS observations at markedly different times; 3) one or more distances were measured to the corner from temporary GNSS observed offset locations.

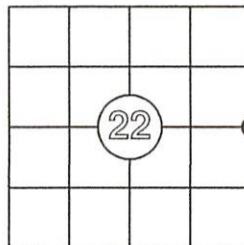

CORNER ID:
3609222000

(b) History of Original Corner Establishment

Corner Set: Wood Post
Original Surveyor: Wm. Daugherty
Date of Survey: July, 1863

Original Bearing Trees:
Y. Pine, 20" S 14° E, 41 links
Birch, 6" N 28° W, 10 links

(b)(f)(g)(h)(i): Description of monument found at this corner and, if it was accepted, state all evidence (material, testimonial, occupational, plats, record, other monuments) used as a basis for establishing location. If re-establishing through lost corner proportionate methods, indicate all monuments, distances and directions used to establish this location. Indicate type of monument and sign post found or set.

This is a continuation of a previous USPLSS Monument Record by Surveyor Devon Vanden Heuvel (1997). See previous record for additional history on this corner.


1/9/1997: Devon Vanden Heuvel, S-1795, notes a found aluminum capped monument for the plat of Aspen Acres

6/1/2006: Jeff DeMuth, S-2656, notes a found aluminum mon.

12/30/2023: I found a 2" diameter iron pipe with a 3" aluminum cap, as described by Vanden Heuvel in 1997. I recovered three of four witness corners and nails. The blazes on the existing trees have grown shut and the nails are now under new growth, so I set new nails in the found bearing trees. I did not find the 8" aspen at N 20° E, 14.50', so I set a new nail in a new bearing tree, all as shown below.

(c)(d)(e) Plan view of corner with ties to at least 4 witness monuments. If in disagreement with previously established corner, show the distances between the two corners and also indicate the ties to the disputed.

1. Found 2" iron pipe with 3" aluminum cap with markings indicating the East 1/4 corner of Section 22-36-09.
2. Set nail in 14" balsam, N 32° W, 41.05' (existing).
3. Set nail in 8" oak, N 20° E, 26.96' (new).
4. Set nail in 16" balsam, N 90° E, 58.73' (existing).
5. Set nail in 12" aspen, N 70° W, 47.03' (existing).
6. Plastic, white sign post, N, 0.6'

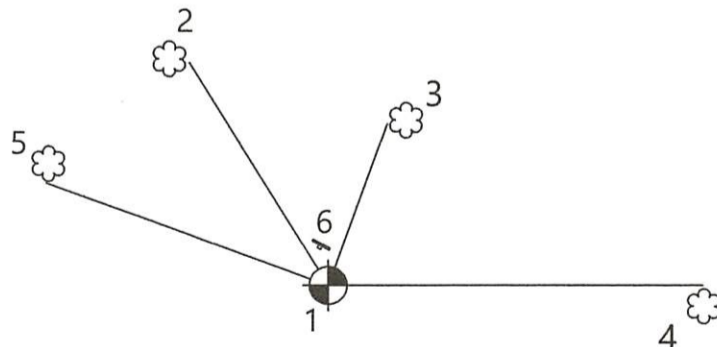

Bearings: Magnetic

Scale: 1"=20'



(i) I, Anthony R. Jones, Wisconsin Professional Land Surveyor No S-2508, hereby certify that the corner location shown on this record was determined by me, or under my direction or control, and that this U.S. Public Land Survey Monument Record is correct and complete to the best of my knowledge and belief.

[Signature]
Anthony R. Jones, PLS No. S-2508 Date: 12/30/23

Index No. _____