

U.S. PUBLIC LAND SURVEY MONUMENT RECORD


Note: This form is intended and designed to fulfill all requirements of Wisconsin Administrative Code, Chapter A-E 7.08 U.S. Public Land Survey Monument Record (3) (a) (b) (c) (d) (e) (f) (g) (h) (i). An additional sheet may be added if necessary to conform with said requirements.

(a) Corner location: Township 36 North

Range 9 East/West

Town/City/Village Pelican Lake

County Oneida

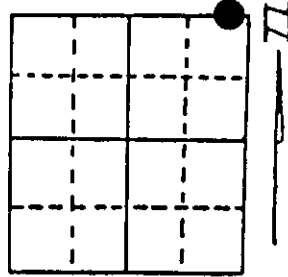

Section 26

(b) (f) (g) (h) Description of monument found at this corner and if it was accepted, state all evidence (material, testimonial, occupational, plats, records, other monuments) used as a basis for accepting. If not accepted or if nothing was found, state evidence used as basis for establishing location. If reestablished through lost corner proportionate methods, indicate all monuments, distances and directions used to establish. Indicate type of monument found or set and sign post.

1863 - Wm. Daugherty established this corner at 1.71 Chains on East Bank of Pelican River and made BTs:

8" Birch, S8°E, 28 Links (18.48') 16" W. Pine, N66°E, 21 Links (13.86')


1924 - Vaughan called corner at 1.71 Chains West of Section Corner when he ran to Quarter Corner to West.

2/11/1992 - Milo E. Stefan found fallen scribed post with location poster attached by Lawrence, 1947. As our distance to the Section Corner Easterly was short by 5'-7', we concluded that the distances to the two original BTs have been reversed. If the 28 Links is given to the Pine BT, we find the distance to the Section Corner conforms to the original notes exceedingly well. We monumented the fallen post position.

(c) (d) (e) Plan view of corner with ties to at least 4 witness monuments. If in disagreement with previously established corner, show the distances between the two corners and also indicate the ties to the disputed corner.

- 1) 2" x 30" aluminum county monument
- 2) 6" White Ash, N65°E, 16.91 feet.
- 3) 8" Red Maple, S82°E, 41.86 feet.
- 4) 6" Red Maple, S41°E, 34.38 feet.
- 5) 6" Red Maple, S11°W, 10.70 feet.
- 6) 18" White Pine Stump, N66°E, 18.5 feet with over-growth on BT blaze.
- 7) Plastic sign post, SW, 1.0 feet.

Distances to nail in side of BTs.
Stump blaze scribed "BT".

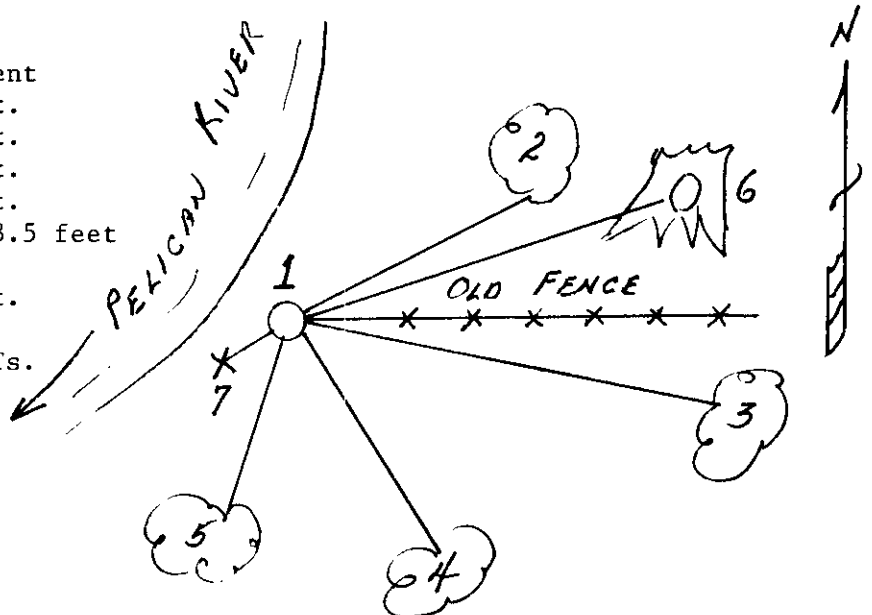

(i) I, Milo E. Stefan
(type or print name) certify that the corner location on this record was determined by me or under my direction and control and that this U.S. Public Land Survey Monument Record is correct and complete to the best of my knowledge and belief.

Milo E. Stefan
Signature

2/28/92
Date



Stamp

3609230003

Index No. R-20, 21