


U.S. PUBLIC LAND SURVEY MONUMENT RECORD

Note: This form is intended and designed to fulfill all requirements of Wisconsin Administrative Code, Chapter A-E 7.08 U.S. Public Land Survey Monument Record (3) (a) (b) (c) (d) (e) (f) (g) (h) (i). An additional sheet may be added if necessary to conform with said requirements.

(a) Corner location: Township 36 North
 Range 9 East/West

Town/City/Village Pelican Lake
 County Oneida

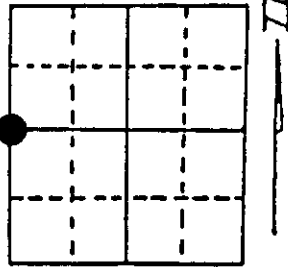

Section 24


(b) (f) (g) (h) Description of monument found at this corner and if it was accepted, state all evidence (material, testimonial, occupational, plats, records, other monuments) used as a basis for accepting. If not accepted or if nothing was found, state evidence used as basis for establishing location. If reestablished through lost corner proportionate methods, indicate all monuments, distances and directions used to establish. Indicate type of monument found or set and sign post.

- 1863 - Wm. Daugherty established this corner at 40.00 Chains with BTs:
 10" Tamarack, N62°E, 31 Links 6" Tamarack, S88°E, 16 Links
- 1924 - Vaughan used corner and ran South to Section Corner, one-half mile.
- 1962 - RIPCO surveyors found 10" Tamarack (down), S34°W, 9 Links and a 6" Tamarack, S9°E, 61½ Links.
- 1975 - Genisot surveyors found BT down.
- 1/8/1992 - Milo E. Stefan found 2" aluminum monument (not stamped) with scribed post, S33°W, 6.2'. Very old North-South fence line East 90 feet.
 When monument was placed, and by whom, remains a mystery. I accept this monument as the perpetuated position of the original Quarter Corner.

(c) (d) (e) Plan view of corner with ties to at least 4 witness monuments. If in disagreement with previously established corner, show the distances between the two corners and also indicate the ties to the disputed corner.

- 1) 2" x 24" high aluminum monument (not stamped).
- 2) 8" Tamarack, N76°E, 20.48 feet.
- 3) 6" Tamarack, S79°E, 40.86 feet.
- 4) 6" Tamarack, S39°E, 16.08 feet.
- 5) 8" Tamarack, S76°W, 14.88 feet.
- 6) Plastic sign post, West, .6 feet.

Distances to nail in side of BTs.
 Stump blaze scribed "BT".

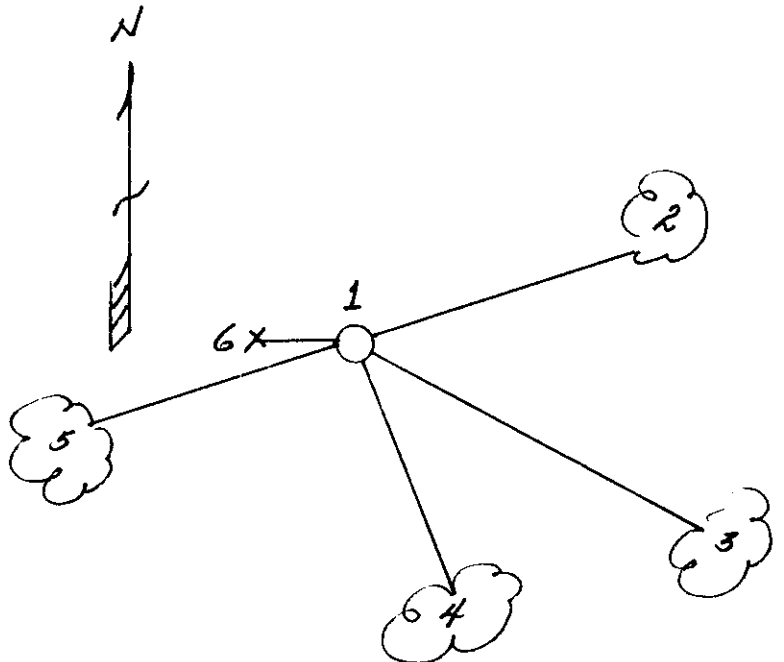

(i) I, Milo E. Stefan
 (type or print name) certify that the corner location on this record was determined by me or under my direction and control and that this U.S. Public Land Survey Monument Record is correct and complete to the best of my knowledge and belief.

Milo E. Stefan
 Signature

2/28/92
 Date



Stamp

Index No. P-21

3609232000