

CERTIFIED LAND CORNER RESTORATION

State of Wisconsin }  
County of Oneida } ss.

I Philip T. Hansen, do hereby certify that on the 25 day of August, 1975, I found evidence of the S 1/16 corner of Sec. 19 and 24 Township 36 N, Range 10 E, Fourth Principal Meridian, as described hereon; and that from this evidence I established a new monument and accessories as described hereon to perpetuate the original location of this corner:

Description of original monument and accessories and subsequent restorations: Corner established by H.C. Lawrence, Registered Land Surveyor, during his retracement survey in 1948. Set corner equidistant between Quarter corner and Sec. corner, 19, 24, 25 and 30. Set 3" Tamarack 99 1/2 lks east of 60.48 chains, south of S. corner, 13, 18, 24 and 19 from which Norway Pine 12" bears S 78° E 108 lks and Norway Pine 14" bears N 9 1/2° E 36 lks.

Description of corner evidence found:


Recovered 3" Tamarack post, squared and scribed S 1/16 S 19, S 1/16 S 24 in very poor condition. Recovered point intact in ground.

Recovered CBT Red Pine 12" (14") S 78° E 108 lks. Scribed S 1/16 S 19 BT  
Red Pine 14" (15") N 9 1/2° (N12°E) 36 lks scribed S 1/16 BT


Description of monument and accessories I established to perpetuate the location of this corner:

Replaced old point of tamarack stake with 1 1/2" OD iron pipe w/2" brass cap stamped No additional accessories established

S 498  
T 36 N R 10 E  
S 1/16 S 24 S 19  
E E  
CPI 1975

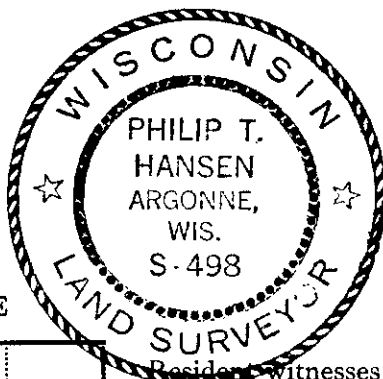

T 36 N R 10 E

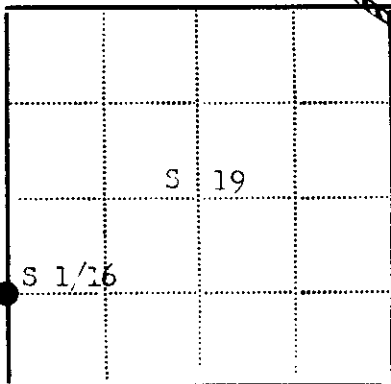

● - Corner monument restored  
□ -

Resident witnesses: Glen Barker and Jim Claflin

Dated at Rhinelander Wisconsin, this 15 day of September 1975.

Signature: Philip T. Hansen Title: Registered Land Surveyor  
(County Surveyor, Registered Land Surveyor, or other duly authorized official)

Surveyors Registration No. S-498

Office of Register of Deeds County of Oneida

I hereby certify that the within instrument was filed in this office for record on the 14th day of October 1975, and was filed in Book No. Page No. of County Records.

Signature: Doris Terage Kunda Title: Register of Deeds

Township 36 N, Range 10 E, Section 19, Index No., Page No.

CERTIFIED LAND CORNER RESTORATION

Supplemental to Q-1

Index No. Q-1

State of Wisconsin


County of Oneida

ss.

History of original corner establishment:  
No records on any survey on this corner.

I, Philip T. Hansen, do hereby certify that on the 17th day of ~~August~~ August, 1979, I ~~restored~~ ~~extended~~ ~~of~~ the S 1/16 corner of Section 24 and 19 Township 36 North, Range 9 & 10 East, Fourth Principal Meridian, as described hereon; and that from this evidence I established a new monument and accessories as described hereon to perpetuate the original location of this corner.

Resident witnesses:  
Glen Barker  
Jim Claflin  
Herb Wagoner

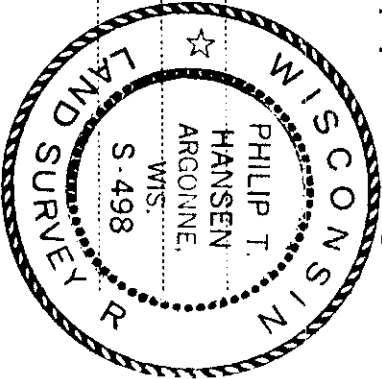


Description of corner evidence found:

On 8/25/75 we recovered H.C. Lawrence's tamarack post and remonumented it with a 1-1/2" iron pipe. This position does not check out with our position established by traverse and computation. Ran traverse from section corner 19, 24, 25 and 30 to the 1/4 corner between 19 and 24. Computed distance is 2679.314 feet at bearing N 6° 04' 43" E. Reset S 1/16 corner at 1339.657' intermediate. This position is S64°W 30.55' from H.C. Lawrence's location.

Description of monument and accessories I established to perpetuate the original location of this corner.  
Moved monument from old position to our new location.

- Marked NBT's -  
Red Pine 8" N79°E 21.15 feet  
White Pine 1 1/2" S43°E 24.25 feet, scribed 1/16 BR.

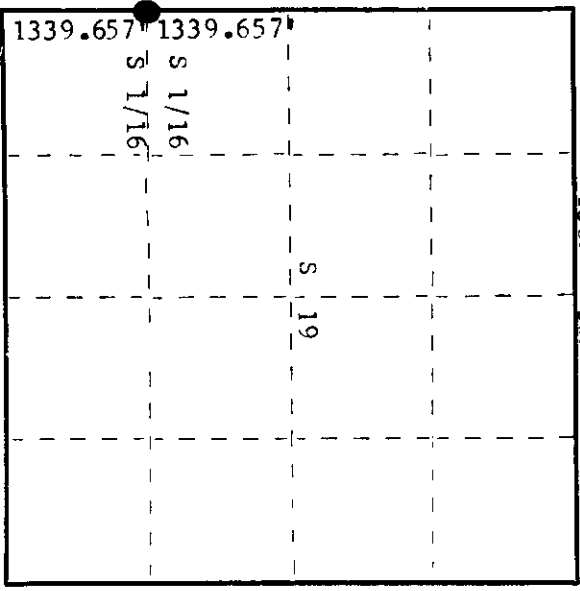

○ = Corner monument restored.

Dated at Rhinelander, Wis., this 20th day of August, 1979.

Signature: *Philip T. Hansen* Title: Registered Land Surveyor Registration No. S-498  
(County Surveyor, Registered Land Surveyor, or other duly authorized official)

Office of Register of Deeds, County of Oneida  
Instrument was filed in this office for record on the 27th day of August, 1979  
at 1:00 o'clock P.M.

Signature: *David George Fisher*  
(Register of Deeds)

By: Deputy

3609241000