

CERTIFIED LAND CORNER RESTORATION

Index No. V-23

State of Wisconsin


County of Oneida

ss.

I, Philip T. Hansen, do hereby certify that on the 30th day of August, 1979, I found evidence of the quarter corner of Sections 25 and 36 Township 36 North, Range 9 East, Fourth Principal Meridian, as described hereon; and that from this evidence I established a new monument and accessories as described hereon to perpetuate the original location of this corner.

Resident witnesses:

Glen Barker
Jim Claffin
Herb Wagner

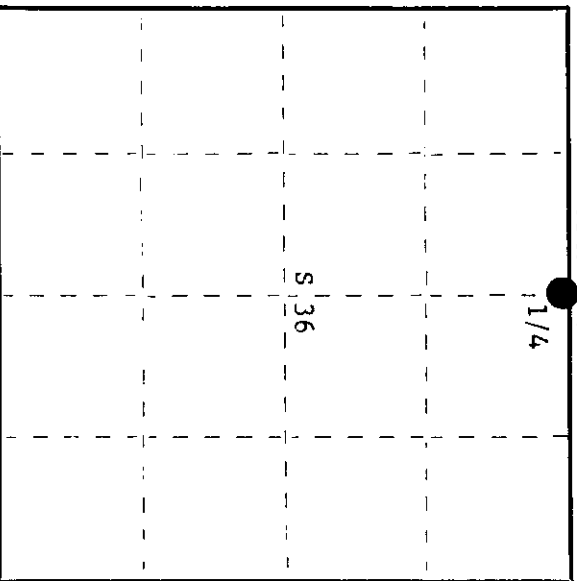

○ = Corner monument restored.

CERTIFIED LAND CORNER RESTORATION

History of original corner establishment:

Original corner established by Wm. E. Dougherty, Deputy Surveyor, from which Birch 10" bears N18°W 29 links and Aspen bears N81°W 41 links. N. Loftus, Ripco surveyor, ran the N-S 1/4 line north, bearing 356° 20', 85.485 chains to close out 22 links east of N 1/4 corner. Set a 1/2" iron pipe 8" long in centerline of old abandoned Highway G. Set a W.C. 8' north of true corner. Marked NBT's - Cedar 5" S12°W 33-1/4 links Cedar 4" N61°W 66-1/4 links

Description of corner evidence found:

Recovered Ripco's 2" iron pipe with brass cap - stamped:
Recovered OBT's -
Cedar 5" S12°W (S15°W) 33.75 links
Cedar 4" (6") N61°W 66.75 links, scribed 1/4 S25 BT.
Monument projects 18" above ground.

T36N R9E
S + 25 W.C.
1/4 S 36
S 13 lks. to Cor.
RIPCO

Description of monument and accessories I established to perpetuate the original location of this corner.
Left monument in place as recovered.
Marked NBT - Maple 7" N51°E 27.3 links, scribed 1/4 BT.

Dated at Rhinelander, Wis., this 10th day of September, 1979

Signature: *Philip T. Hansen* Title: Registered Land Surveyor Registration No. S-498
(County Surveyor, Registered Land Surveyor, or other duly authorized official)

Office of Registrar of Deeds, County of Oneida
Instrument was filed in this office for record on the 17th day of September, 1979
at 10:50 o'clock P.M.

Signature: *Donna Savage Fuchs*
(Registrar of Deeds)

By: Deputy

3609250020