CERTIFIED LAND CORNER RESTORATION

Index No. V-22

State of Wisconsin
County of Oneida } ss.

I Philip T. Hansen, do hereby certify that on the 1st day of August, 1979, I found evidence of the W 1/16 corner of Sections 25 and 36 Township 36, North, Range 9 East, Fourth Principal Meridian, as described hereon; and that from this evidence I established a new monument and accessories as described hereon to perpetuate the original location of this corner.

Resident witnesses:

Jim Claflin

Herb Wagoner

WISCONSIN PHILIP T. HANSEN ARGONNE, WIS. S-498 LAND SURVEYOR

FORM 985

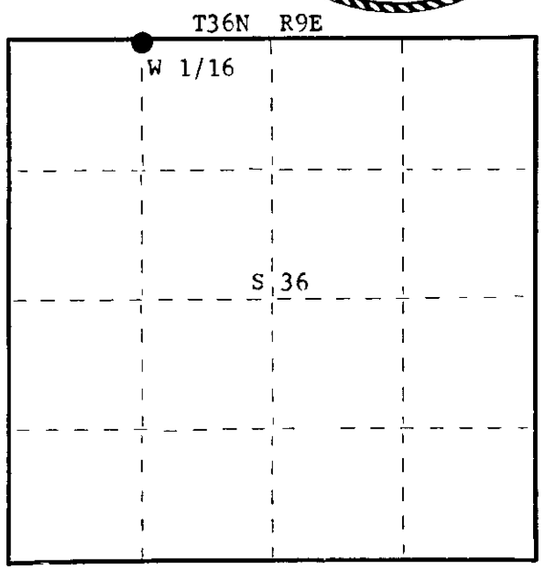

O = Corner monument restored.

History of original corner establishment:

Corner established by Goddard and crew, Ripco surveyors, in 1959. Ran random line west from NE corner Section 36 to NW Section Corner. Established N 1/4 corner at 42.02 chains and tied into NW 1/4 at 84.06 chains. Set W 1/16 intermediate at 63.04 chains.
Marked NBT's -
Cedar 5" S22°W 66 links
Cedar 10" N56°E 65 links
Corrected bearing N88° 26' W.

Description of corner evidence found:

Recovered Ripco's OBT to set corner. No evidence of corner. Corner sets in old abandoned grade of old Highway "G"
Recovered Ripco's OBT's -
Cedar 5" S22°W 66 links, dead but still standing.
Cedar 10" N56°E - destroyed by road construction new Highway G.

Description of monument and accessories I established to perpetuate the original location of this corner.

Set a 1-1/2" iron pipe with 2" brass cap, projecting 18" - stamped:

Marked NBT -
Cedar 7" S8°E 95.4 links, scribed 1/16 BT.
Power Pole #307 N74°W 128.26 links
(nail in south side).

T36N R9E
W 1/16 S 25 / S 36
CPI-1979

Dated at Rhinelander, Wis., this 7th day of August, 1979.

Signature Philip T. Hansen Title Registered Land Surveyor Registration No. S-498
(County Surveyor, Registered Land Surveyor, or other duly authorized official)

Office of Register of Deeds, County of Oneida, I hereby certify that the within instrument was filed in this office for record on the 27th day of August, 1979 at 1:00 o'clock P. M.

Doris Verage Kuehn
(Register of Deeds)

By ..... Deputy

3609250030