

CERTIFIED LAND CORNER RESTORATION

Index No. U-1

State of Wisconsin

County of Oneida } ss.



History of original corner establishment:
H. C. Lawrence established corner in 1947.

I, Glen Barker, do hereby certify that on the 13th day of ~~established~~ ^{June} 1984, I ~~renewed~~ ^{reestablished} the ~~corner~~ ^{corner} of Sections 25 & 30 Township 36 North, Range 9 & 10 East, Fourth Principal Meridian, as described hereon; and that from this evidence I established a new monument and accessories as described hereon to perpetuate the original location of this corner.

Resident witnesses:

N. Spiess

H. Wagoner

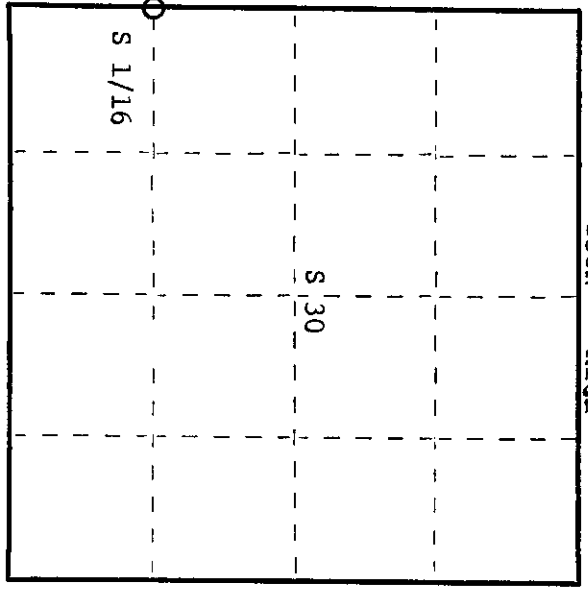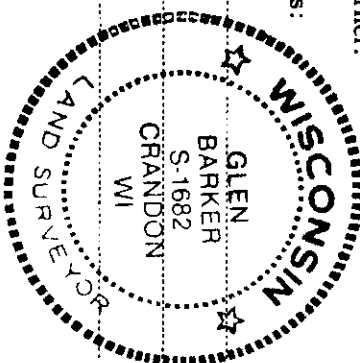

○ = Corner monument restored.

Description of corner evidence found:

Total distance from 1/4 corner between sections 25 & 30 T36N R9&10E is 2662.29'.
Set S 1/16 1331.15' intermediate.
Old cedar post bears N54-08-30E 1.25' of new established monument.

Description of monument and accessories I established to perpetuate the original location of this corner.

Set a 1" iron pipe with 2" diameter alloy cap, stamped:
Monument projects 18" above ground.
Marked NBT:
Black Ash 6" S20W 8.89'
Old B.T.:
Tamarack 7" N37W 17.70'
S 1/16 25 + 30
R9E R10E
CPI-1984

Dated at Malineland, Wis., this 8th day of August, 1984

Signature Glen Barker Title Registered Land Surveyor Registration No. S1682
(County Surveyor, Registered Land Surveyor, or other duly authorized official)

Office of Register of Deeds, County of Oneida I hereby certify that the within instrument was filed in this office for record on the 10th day of December, 1984 at 1:30 o'clock P.M.

Dore Vange Kuehn
(Register of Deeds)

By _____ Deputy

3609251000