

CERTIFIED LAND CORNER RESTORATION

Index No. 3-1

State of Wisconsin

County of Oneida } ss.

History of original corner establishment:  
A 1" iron pipe bears N34-31-08W 2.83' of new established corner.


I, Glen Barker, do hereby certify that on the 28th day of June, 1984, I ~~found~~ established the corner of Sections 25 & 30 Township 36 North, Range 9 & 10 East, Fourth Principal Meridian, as described hereon; and that from this evidence I established a new monument and accessories as described hereon to perpetuate the original location of this corner.

Description of corner evidence found:  
Total distance from 1/4 corner between sections 25 & 30 to section corner 24-25-19-30 T36N R9&10E is 2644.61'.  
Set N 1/16 1322.30' intermediate.

Resident witnesses:

N. Spiess

H. Wagoner

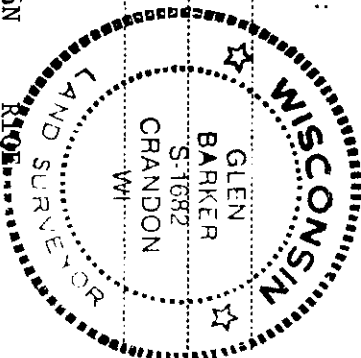

Description of monument and accessories I established to perpetuate the original location of this corner.

Set a 1" iron pipe with 2" diameter alloy cap, stamped:  
Monument projects 18" above ground.

Marked NBTs:  
White Pine 10" N69E 23.28' S1682  
White Pine 8" S46W 20.00' T36N  
scribed 1/16 B.T. N 1/16 25-30 R9E - R10E  
CPI - 1984

Dated at Rhinelander, Wis., this 13th day of August, 1984

Signature: *Glen Barker* Title: Registered Land Surveyor Registration No. S1682  
(County Surveyor, Registered Land Surveyor, or other duly authorized official)

Office of Register of Deeds, County of Oneida, hereby certify that the within instrument was filed in this office for record on the 10th day of December, 1984 at 11:30 o'clock A.M.

*Tom George Fuchs*  
(Register of Deeds)

○ = Corner monument restored.

By: Deputy

3609253000