

CERTIFIED LAND CORNER RESTORATION

State of Wisconsin }  
County of Oneida } ss.

I William Immich, do hereby certify that on the 13th day of August, 1981, I found evidence of the South 1/4 corner of Section 27, Township 36 North, Range 9 East, Fourth Principal Meridian, as described hereon; and that from this evidence I established a new monument and accessories as described hereon to perpetuate the original location of this corner:

Description of original monument and accessories and subsequent restorations:

William Daughterty, Government Surveyor  
Set 1/4 post 40.30 Birch 10 N 40 E 39  
Aspen 10 S 51 E 65

E.F. Dorr 1895 N 1/4 P Birch double 12 N 54 1/2 W 39  
Cedar 8 N 20 W 48 3/4

Ralph Bergman land owner replaced Dorrs wood post with a well point bearing trees were in place at time.


Description of corner evidence found:

Found well point set by Ralph Bergman




Description of monument and accessories I established to perpetuate the location of this corner:

Set bernsten monument stamped as shown:

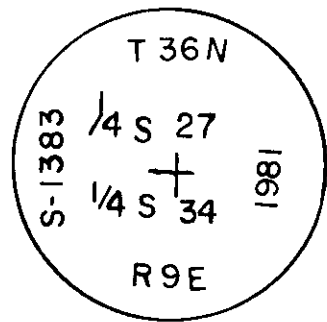

new bearing trees:  
norway pine 17 S 89 E 15.71'  
balsam 5 S 11 W 6.59'  
maple 5 N 85 W 22.45'  
(trees scribed 1/4 S distance to P.K. nail in blaze)

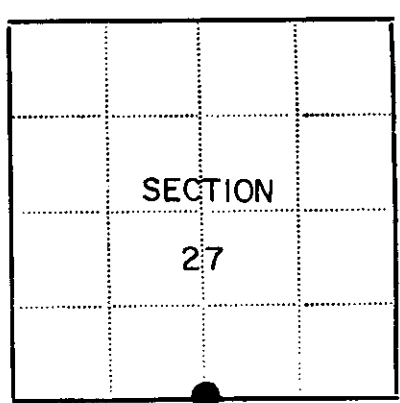

● - Corner monument restored  
□ -

Resident witnesses.....

Dated at Rhinelander Wisconsin, this 18 day of August 19 81.

Signature *Willa Immich* Title Registered Land Surveyor  
(County Surveyor, Registered Land Surveyor, or other duly authorized official)

Surveyors Registration No.....

Office of Register of Deeds County of Oneida

I hereby certify that the within instrument was filed in this office for record on the 11 day of June 1980, and was filed in Book No. .... Page No. .... of County Records.

Signature *Doris Bergman* Title Reg. of Deeds  
*Opelona A. Hiss Deputy*

Township....., Range....., Section....., Index No....., Page No.....

3609270020

Y-15