U.S. PUBLIC LAND SURVEY MONUMENT RECORD

Note: This form is intended and designed to fulfill all requirements of Wisconsin Administrative Code, Chapter A-E 7.08 U.S. Public Land Survey Monument Record (3) (a) (b) (c) (d) (e) (f) (g) (h) (i). An additional sheet may be added if necessary to conform with said requirements.

(a) Corner location: Township 35 North

Range 9 East/~~West~~

Town/~~City/Village~~ Enterprise

County Oneida

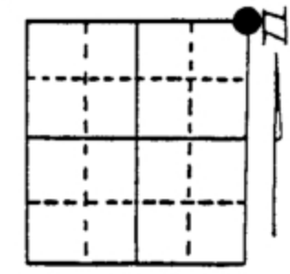

Section 5

(b) (f) (g) (h) Description of monument found at this corner and if it was accepted, state all evidence (material, testimonial, occupational, plats, records, other monuments) used as a basis for accepting. If not accepted or if nothing was found, state evidence used as basis for establishing location. If reestablished through lost corner proportionate methods, indicate all monuments, distances and directions used to establish. Indicate type of monument found or set and sign post.

1859 - Hiram Fellows established this corner and set a wood post with four BTs:
5" Alder, N37°W, 55 Links — 9" Spruce, N65°E, 25 Links
7" Tamarack, S80°E, 17 Links — 8" Spruce, S45°E, 15 Links

4/18/1936 - Maine found two scribed 20" Tamarack BTs and he set a 2 1/4" x 60" iron pipe/brass cap and three new BTs:
7" Black Ash, S14°E, 71 Links — 6" Soft Maple, S68°W, 33 1/2 Links
10" Soft Maple, N62°W, 1.49 Chains

12/5/1989 - Milo E. Stefan found Maine's monument lying down with northwest BT okay; others all gone. We made three new BTs, reset monument and set plastic sign post.

(c) (d) (e) Plan view of corner with ties to at least 4 witness monuments. If in disagreement with previously established corner, show the distances between the two corners and also indicate the ties to the disputed corner.

1) 2 1/4" x 60" iron pipe/brass cap
2) 10" White Spruce, N6°E, 22.98'
3) 14" White Spruce, N20°E, 43.50'
4) 5" White Spruce, S9°E, 10.72'
5) 18" Red Maple, N62°W, 97.41' (Maines)
6) Plastic sign post, southeast, .2'

Distances to nail in side of trees.
BT stumps scribed "BT".

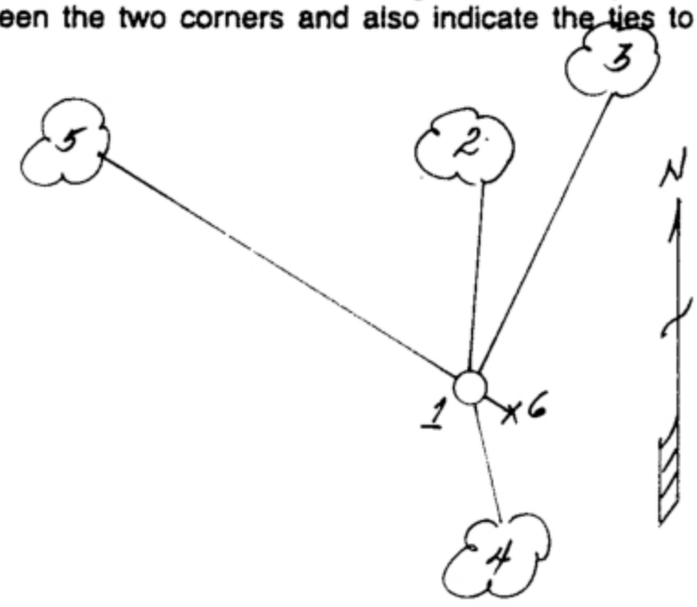

(i) I, Milo E. Stefan (type or print name) certify that the corner location on this record was determined by me or under my direction and control and that this U.S. Public Land Survey Monument Record is correct and complete to the best of my knowledge and belief.

Milo E. Stefan — 12/5/89

Signature — Date

WISCONSIN MILO E. STEFAN S-1355 RHINELANDER, WIS. LAND SURVEYOR

Index No. A-9

3609320000