


# U.S. PUBLIC LAND SURVEY MONUMENT RECORD

**Note:** This form is intended and designed to fulfill all requirements of Wisconsin Administrative Code, Chapter A-E 7.08 U.S. Public Land Survey Monument Record (3) (a) (b) (c) (d) (e) (f) (g) (h) (i). An additional sheet may be added if necessary to conform with said requirements.

(a) Corner location: Township 35 North  
 Range 9 East/West

Town/City/Village Enterprise

County Oneida

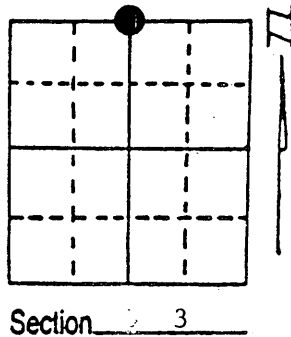

(b) (f) (g) (h) Description of monument found at this corner and if it was accepted, state all evidence (material, testimonial, occupational, plats, records, other monuments) used as a basis for accepting. If not accepted or if nothing was found, state evidence used as basis for establishing location. If reestablished through lost corner proportionate methods, indicate all monuments, distances and directions used to establish. Indicate type of monument found or set and sign post.

1859 - Hiram Fellows established this corner and set a wood post with two BTs:  
 20" Hemlock, S35°W, 7 Links                      15" Hemlock, N75°E, 10 Links


4/16/1936 - Maine found original BT down with marks plain. Also, two of Vaughan's BTs:  
 10" Hemlock, S71°E, 23 links; 10" Hemlock stub, south, 29 links. Maine restored corner by placing a 2 1/4" x 60" iron pipe with brass cap and three new BTs:  
 8" Elm, S74°E, 36 Links                      8" Sugar, N64°E, 30 1/2 Links  
 8" Elm, N4 1/2°E, 25 Links

12/5/1989 - Milo E. Stefan found Maine's monument in good condition. Elm and Hemlock - gone. Sugar Stump N64°E, 30 1/2 links. We made four new BTs and set plastic sign post.

(c) (d) (e) Plan view of corner with ties to at least 4 witness monuments. If in disagreement with previously established corner, show the distances between the two corners and also indicate the ties to the disputed corner.

- 1) 2 1/4" x 60" iron pipe/brass cap
- 2) 10" Sugar Maple, N21°E, 30.30'
- 3) 8" Black Ash, S78°E, 26.87'
- 4) 8" Sugar Maple, S24°W, 21.49'
- 5) 7" Sugar Maple, N9°W, 7.64'
- 6) Plastic sign post, south, .6'

Distances to nail in side of trees.  
 BT stump scribed "BT".

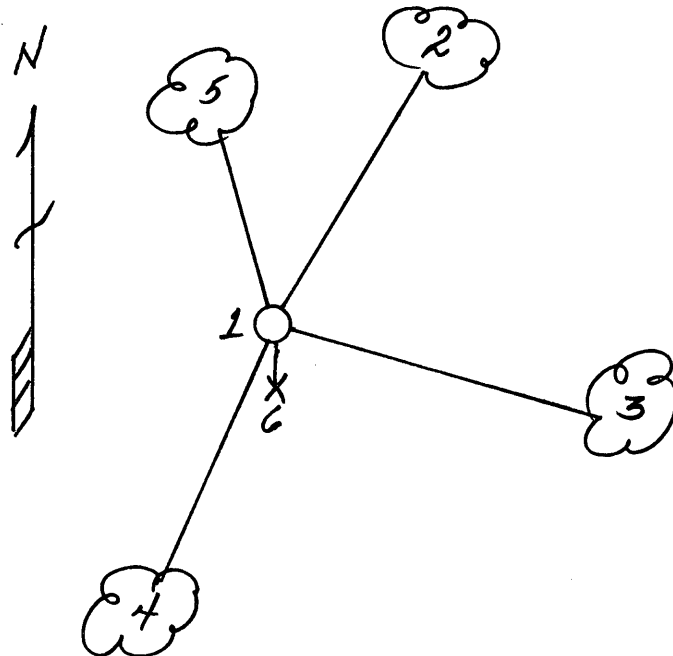

(i) I, Milo E. Stefan  
 (type or print name) certify that the corner location on this record was determined by me or under my direction and control and that this U.S. Public Land Survey Monument Record is correct and complete to the best of my knowledge and belief.

Milo E. Stefan                      12/5/89  
 Signature                                      Date



Index No. A-15