U.S. PUBLIC LAND SURVEY MONUMENT RECORD

Note: This form is intended and designed to fulfill all requirements of Wisconsin Administrative Code, Chapter A-E 7.08 U.S. Public Land Survey Monument Record (3) (a) (b) (c) (d) (e) (f) (g) (h) (i). An additional sheet may be added if necessary to conform with said requirements.

(a) Corner location: Township 35 North

Range 9 East/~~West~~

Town/~~City/Village~~ Enterprise

County Oneida

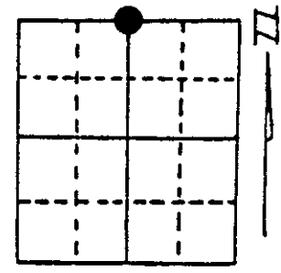

Section 2

(b) (f) (g) (h) Description of monument found at this corner and if it was accepted, state all evidence (material, testimonial, occupational, plats, records, other monuments) used as a basis for accepting. If not accepted or if nothing was found, state evidence used as basis for establishing location. If reestablished through lost corner proportionate methods, indicate all monuments, distances and directions used to establish. Indicate type of monument found or set and sign post.

1859 - Hiram Fellows established this corner and set a wood post and two BTs:
10" Hemlock, S71°E, 23 Links 8" Hemlock, N35°W, 20 Links

4/13/1936 - Maine found remains of original BTs and a BT set by Vaughn, a 30" White Pine stump, N55°W, 42 links. He set a 2 1/4" x 60" iron pipe with brass cap and made two BTs:
12" Red Pine Stump, S33°W, 43 Links 7" Black Ash, East, 81 Links

11/15/1989 - Milo E. Stefan found monument set by Maine under fallen birch and under 6" of leaf litter with Ash bearing tree alive, Red Pine Stump in place and Vaughn's White Pine Stump nearly gone. We made new BTs and set plastic sign post.

(c) (d) (e) Plan view of corner with ties to at least 4 witness monuments. If in disagreement with previously established corner, show the distances between the two corners and also indicate the ties to the disputed corner.

1) 2 1/4" x 60" iron pipe with brass cap
2) 10" Black Ash, N40°E, 18.01'
3) 11" Black Ash, East, 53.78'
4) 5" Sugar Maple, S8°E, 22.90'
5) Red Pine Stump by Maine, S33°W, 28.38'
6) 12" Red Maple, N58°W, 14.22'
7) White Pine Stump by Vaughn, N55°W, 27.7'
8) Plastic sign post, northeast, .5'

Distances to nail in side of BTs

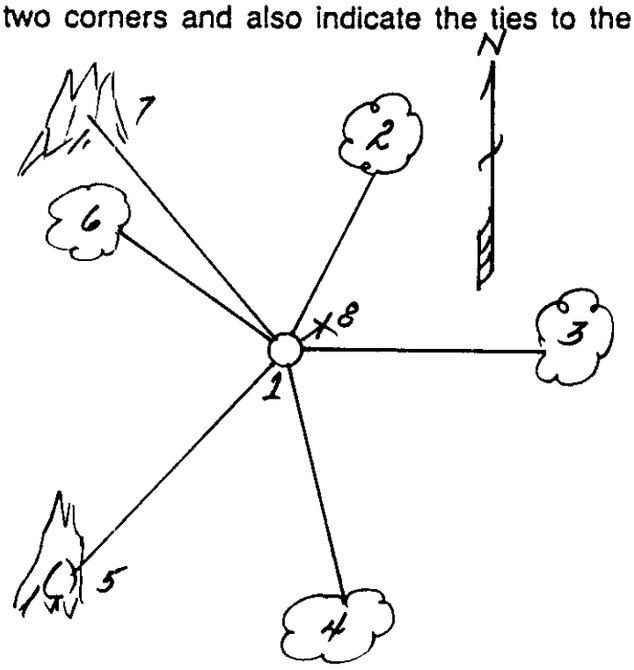

(i) I, Milo E. Stefan (type or print name) certify that the corner location on this record was determined by me or under my direction and control and that this U.S. Public Land Survey Monument Record is correct and complete to the best of my knowledge and belief.

Milo E. Stefan
Signature

11/17/89
Date

WISCONSIN MILO E. STEFAN S-1558 RHINELANDER, WIS. LAND SURVEYOR

Index No. A-19