
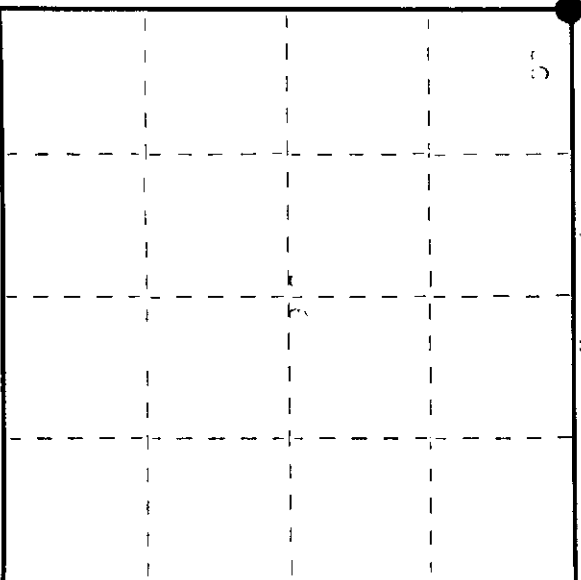


State of Wisconsin

County of _____ } ss.

I _____ do hereby certify that on the _____ day of _____, 19____, I found evidence of the _____ corner of _____ Township _____ North, Range _____ Fourth Principal Meridian, as described hereon; and that from this evidence I established a new monument and accessories as described hereon to perpetuate the original location of this corner.

Resident witnesses:

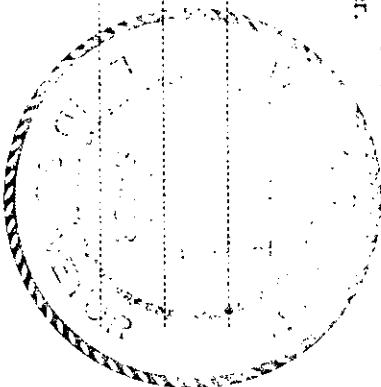

○ = Corner monument restored.

History of original corner establishment:

[Faint, illegible text describing the history of the original corner establishment.]

Description of corner evidence found:

[Faint, illegible text describing the corner evidence found.]

Description of monument and accessories I established to perpetuate the original location of this corner.

[Faint, illegible text describing the monument and accessories.]

Dated at _____ Wis., this _____ day of _____, 19____

Signature *Willie D. Starnum* Title _____ Registration No. _____
(County Surveyor, Registered Land Surveyor, or other duly authorized official)

Office of Register of Deeds, County of _____ I hereby certify that the within instrument was filed in this office for record on the _____ day of _____ at _____ o'clock _____ M. 19____

William W. Kuehner
(Register of Deeds)

By _____ Deputy