

CERTIFIED LAND CORNER RESTORATION


Index No. X-1

State of Wisconsin

County of Oneida } ss.

I Phillip T. Hansen, do hereby certify that on the 13th day of August, 1979, I found evidence of the 1/4 corner of Section 36 and 31 Township 36, North, Range 9 & 10 East, Fourth Principal Meridian, as described hereon, and that from this evidence I established a new monument and accessories as described hereon to perpetuate the original location of this corner.

Resident witnesses:
Glen Barker
Jim Claffin
Herb Wagoner

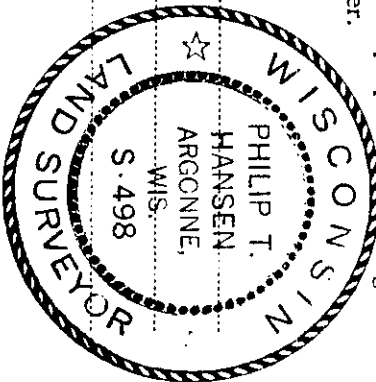

History of original corner establishment:
 Original corner established by Hiram C. Fellows, Deputy Surveyor, in 1859 from which Cedar 6" bears N70°W 12 links and Tamarack 10" bears N65°E 6 links. Corner re-established by Goddard and crew, Ripco surveyors, in 1959, from which Hemlock 6" bears S42°E 26-1/2 links; Cedar 6" bears N34°W 36 links.


Description of corner evidence found:

Recovered 2-1/2" iron pipe with 4" square brass cap, projecting 24" above ground. Cap stamped:

Recovered CRT's -
 Hemlock 6" (8") S42°E 26.5 links (27.3 links) scribbling grown over. 1/4
 Cedar 6" (7") N34°W 36 links (36.5 links) scribbling grown over. S36/S31
 36-9 36-10

Description of monument and accessories I established to perpetuate the original location of this corner.

Left iron pine in place as recovered, painted lt blue.
 Marked NBT's -
 Maple 6" S87°W 30.4 links
 Maple 6" S84°E 28.3 links, scribed 1/4 BT.

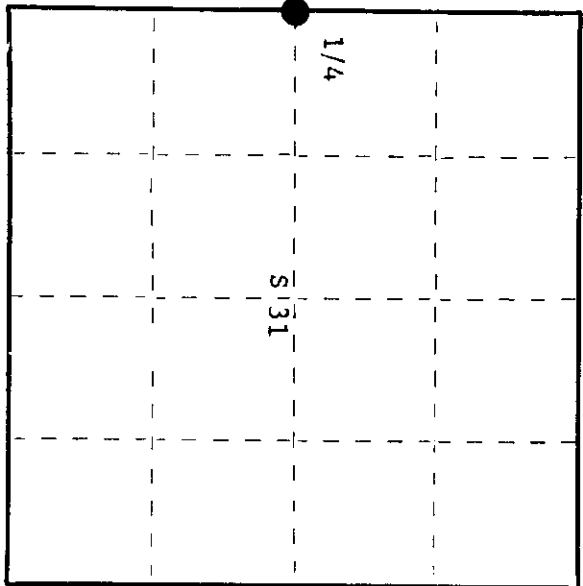

○ = Corner monument restored.

Dated at Rhinelander, Wis., this 14th day of August, 1979

Signature Phillip T. Hansen Title Registered Land Surveyor Registration No. S-498
 County Surveyor, Registered Land Surveyor, or other duly authorized official)

Office of Register of Deeds, County of Oneida
 Instrument was filed in this office for record on the 27th day of August, 1979
 at 10 o'clock A.M.

Richard A. Kind
 (Register of Deeds)

By: _____ Deputy

3609362000