

CERTIFIED LAND CORNER RESTORATION

Index No. **E-25**

State of Wisconsin

County of **Oneida** } ss.

I **Phillip T. Hansen**, do hereby certify that on the **3rd** day of **January**, 19**77**, I found evidence of the **Section Corner** corner of **1-6, 7 & 12** Township **36** North, Range **10 & 11 East**, Fourth Principal Meridian,


as described hereon; and that from this evidence I established a new monument and accessories as described hereon to perpetuate the original location of this corner.

Resident witnesses:

Glen Barker

Jim Claflin

Herb Maganer

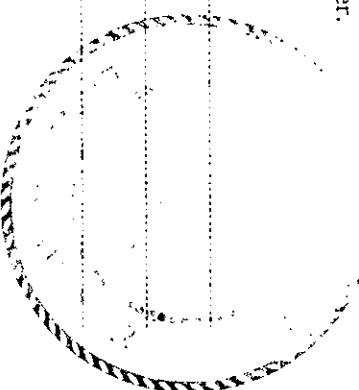

History of original corner establishment:
Original Corner established by Hiram C. Fellows, Deputy Surveyor, in 1859, from which Spruce 8" bears N 4° W 82 links, Tamarack 8" bears N 76° E 178 links, Tamarack 8" bears S 84° E 141 links.
Corner recovered by H.C. Lawrence, Registered Land Surveyor, in 1951. He recovered the original tamaracks and set a new post and marked NBTs - Tamarack 8" S 72° E 185 links. Also found a 2 1/2" iron pipe with brass cap, not stamped.

Description of corner evidence found:
Recovered the point of Lawrence's post and the 2 1/2" iron pipe laying on ground beside it. While digging the hole to set new monument, found the remains of another old post which may have been the original.
Recovered OBT - Tamarack 8" (10") S 72° E 185 links, scribed S7BT.

Description of monument and accessories I established to perpetuate the original location of this corner.
Reset the iron pipe with brass cap in old point hole. Cap stamped:
Monument projects 12" above ground.
Monument sets 20 links west of the west bank of Hay Meadow Creek.
NBT - Tamarack 8" N 52° E 2.49 chains - scribed SC BT.
This area is all alders, no other suitable trees for BT.
R T36N R 11
10 Sec. 11 6
12 7
CPI-1977

Dated at **Rhinelander**, Wis., this **20th** day of **January**, 19**77**.

Signature **Phillip T. Hansen** Title **Registered Land Surveyor** Registration No. **S-498**
(County Surveyor, Registered Land Surveyor, or other duly authorized official)

Office of Register of Deeds, County of **Oneida**
Instrument was filed in this office for record on the **24th** day of **January**, 19**77** at **1:20** o'clock **P.** M.

Veronica Wenzel Fischer
(Register of Deeds)

By _____ Deputy

3610010000