

CERTIFIED LAND CORNER RESTORATION

Index No. **E-22**

History of original corner establishment:

Corner established by D.H. Vaughan, County Surveyor, and recovered by H.C. Lawrence, Registered Land Surveyor, in 1949. H.C. Lawrence set a new post and marked NBT's - Cedar 6" N55°W 3 1/2 links; and Cedar 10" S56°E 27 links.

Description of corner evidence found:

Recovered H.C. Lawrence's 4" squared cedar post, scribed W 1/16 S1, W 1/16 S12, standing in poor condition.  
Recovered OBT -  
Cedar 6" N55°W 3.5 links (13.5 links), now a 2' stump, scribed 1/8S BT.  
Cedar 10" S56°E, could not be found.

Description of monument and accessories I established to perpetuate the original location of this corner.

Replaced cedar post with 1 1/2" iron pine with 2" brass cap, stamped:  
Monument projects 18" above ground.  
Marked NBT's -  
Cedar 10" S20°E 51.1 links. S498  
Black Ash 6" S74°W, 56.8 links. T36N R10E  
both scribed 1/16 BT. W 1/16 S 1-12  
CPI-1979

State of Wisconsin

County of Oneida } ss.



I, Phillip T. Hansen, do hereby certify that on the 12th day of January, 1979, I found evidence of the W 1/16 corner of Section 1 and 12 Township 36, North, Range 10 East, Fourth Principal Meridian, as described hereon; and that from this evidence I established a new monument and accessories as described hereon to perpetuate the original location of this corner.

Resident witnesses:

Glen Barker

Jim Clafflin

Herb Wagoner

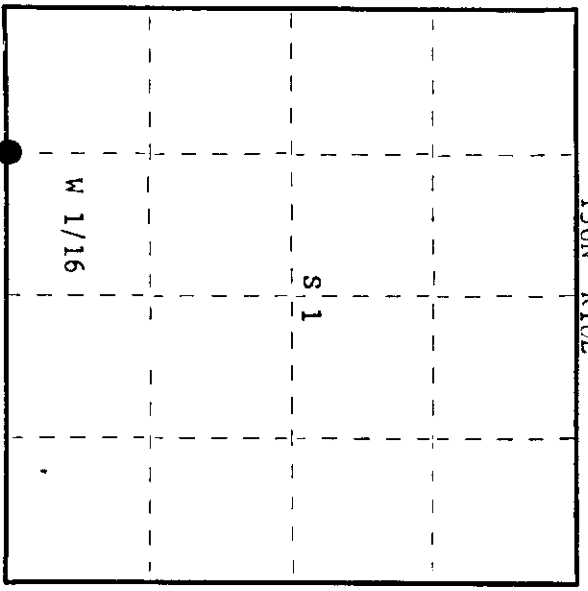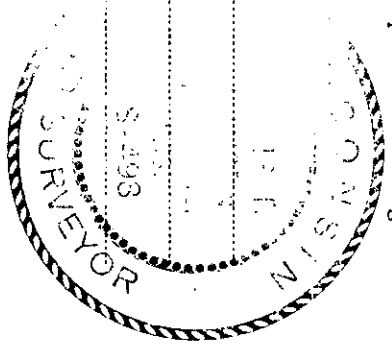

○ = Corner monument restored.

Dated at Rhineland, Wis., this 18th day of January, 1979

Signature Phillip T. Hansen Title Registered Land Surveyor Registration No. S-498  
(County Surveyor, Registered Land Surveyor, or other duly authorized official)

Office of Register of Deeds, County of Oneida  
Instrument was filed in this office for record on the 21st day of January, 1979  
at 2:30 o'clock P. M.

Dorcas Terape Kuehn  
(Register of Deeds)

By Dorcas Terape Kuehn Deputy

3610010030