

State of Wisconsin

County of **Oneida** } ss.



I **Phillip T. Hansen**, do hereby certify that on the **14th** day of **March**, 19**78**, I found evidence of the **Quarter** corner of **Section 1 & 6** Township **36N**, North, Range **10 & 11 E**, Fourth Principal Meridian, as described hereon; and that from this evidence I established a new monument and accessories as described hereon to perpetuate the original location of this corner.

Resident witnesses:

Glen Barker

Jim Claflin

Herb Wagoner

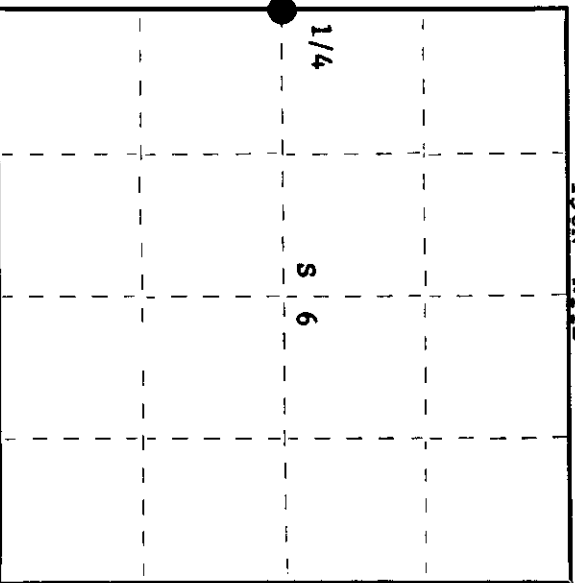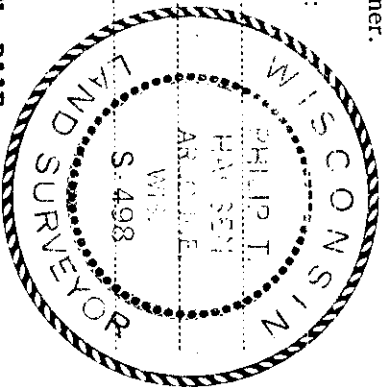

○ = Corner monument restored.

History of original corner establishment:

Original corner established by Hiram C. Fellows, Deputy Surveyor, in 1859, from which yellow pine 8" bears S71°W, 9 links and birch 8" bears N78°E, 10 links. H.C. Lawrence, Registered Land Surveyor, recovered an iron pipe with brass cap but no stamping. He recovered the original yellow pine BT S71°W, 9 links (stump). Set new post, but no records of any NBT's established.

Description of corner evidence found:

Recovered 2 1/2" iron pipe with brass cap (not stamped) projecting 30" above ground. Also recovered Lawrence's 6" squared cedar post laying down under the snow. Recovered stump of original yellow pine BT S71°W, 9 links.

Description of monument and accessories I established to perpetuate the original location of this corner.

As iron pipe was in perfect condition, it was left in place and stamped:

- Marked NBT's - white spruce 5" S16°W, 25.8 links R S498 R
- black spruce 7" S70°W, 36 links R 10 T36N 11
- black spruce 7" N38°W, 48.2 links E 4 S11 S6 E
- black spruce 6" N42°E, 37.2 links
- all scribed 1/4 BT.

Corner sets on south edge of black spruce swamp. CPI-1978

Dated at **Rhinelander**, Wis., this **17th** day of **March**, 19**78**.

Signature: *Phillip T. Hansen* Title: **Registered Land Surveyor** Registration No. **S-498**
(County Surveyor, Registered Land Surveyor, or other duly authorized official)

Office of Register of Deeds, County of **Oneida**, I hereby certify that the within instrument was filed in this office for record on the **10th** day of **April**, 19**78** at **3:00** o'clock **P.**M.

Tonia Leverage Fisher
(Register of Deeds)

By: _____ Deputy

00002001291