

CERTIFIED LAND CORNER RESTORATION



Index No. B-23

State of Wisconsin

County of Oneida } ss.

I, Phillip T. Hansen, do hereby certify that on the 11th day of January, 1979, I found evidence of the NC 1/16 corner of Section 1 Township 36, North, Range 10 East, Fourth Principal Meridian, as described hereon; and that from this evidence I established a new monument and accessories as described hereon to perpetuate the original location of this corner.

Resident witnesses:
Glen Barker
Jim Clafflin
Herb Wagoner

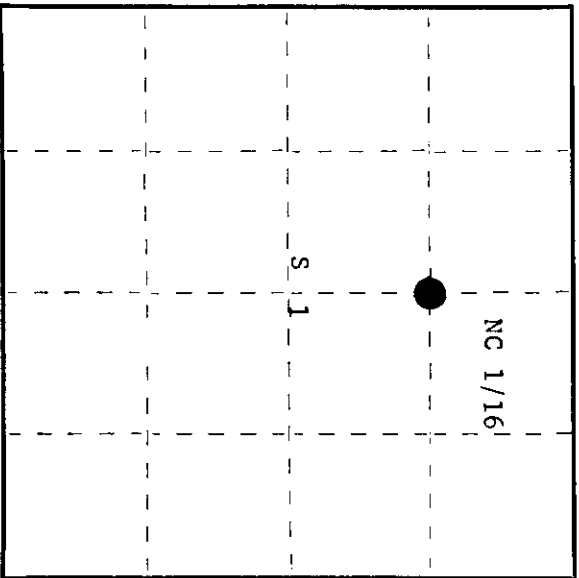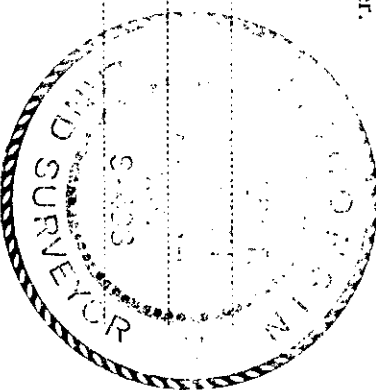

History of original corner establishment:

Corner established by D.H. Vaughan, County Surveyor, in 1906. Marked NBT's - Y.Fine 8" N45°E 23 links; Y.Pine 12" S61°W 15 links.

Corner recovered by H.C. Lawrence, Registered Land Surveyor, in 1949. Recovered Vaughan's old post laying down and burned.

Recovered burned remains of his BT's. Set new tamarack post and marked NBT's - W. Birch 5" S20°W 5 links.

Description of corner evidence found:

Recovered the point of H.C. Lawrence's tamarack post which had rotted off at ground level.
Recovered Vaughan's OBT - Y.Fine stump 8" N45°E 23 links, scribed BT.
Recovered Lawrence's CRT - W.Birch 5" (10") S20°W 5 links, scribing grown over.

Description of monument and accessories I established to perpetuate the original location of this corner.

Replaced point of H.C. Lawrence's tamarack post with 1 1/2" iron pipe with 2" diameter brass cap projecting 24" - cap stamped:
Marked NBT's - W.Spruce 10" S30°E 36 links, scribed 1/16 BT.

S498
T36N R10E
NC 1/16 S 1
CPI-1979

Dated at Rhineland, Wis., this 18th day of January, 1979.

Signature Phillip T. Hansen, Title Registered Land Surveyor Registration No. S-498
(County Surveyor, Registered Land Surveyor, or other duly authorized official)

Office of Register of Deeds, County of Oneida
Instrument was filed in this office for record on the 25th day of January, 1979
at 1:15 o'clock P. M.

Doris Savage Kuehn
(Register of Deeds)

By Doris Savage Kuehn Deputy

2610013020