

CERTIFIED LAND CORNER RESTORATION



Index No. **E-19**

State of Wisconsin

County of Oneida } ss.

I, Phillip T. Hansen, do hereby certify that on the 4th day of October, 1978, I found evidence of the Quarter corner of Sections 2 & 11 Township 36, North, Range 10 East, Fourth Principal Meridian, as described hereon; and that from this evidence I established a new monument and accessories as described hereon to perpetuate the original location of this corner.

Resident witnesses:
Glen Barker
Jim Clafin
Herb Wagoner

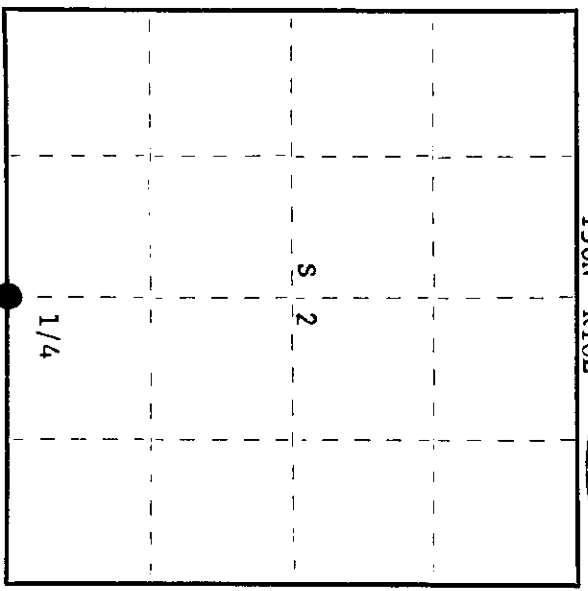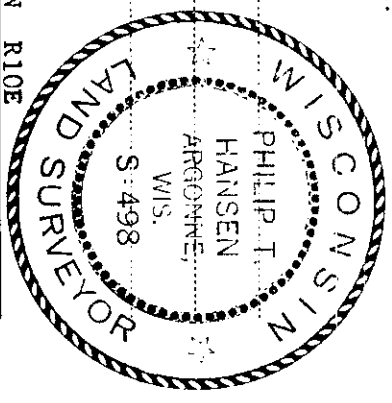

O = Corner monument restored.

History of original corner establishment:

Original corner established by Wm. E. Dougherty, Deputy Surveyor, in 1863, from which Birch 12" bears N 55° W, 60 links and Birch 10" bears S 12° E, 11 links. H.C. Lawrence, Registered Land Surveyor, recovered an iron pipe and stumps of OBT's - Tamarack 9" N 81 1/2° W, 15 1/2 links and Yellow Pine 26" N 8° W, 6 links, in 1947.

Description of corner evidence found:

Recovered a 2 1/2" iron pipe with brass cap buried beneath old balsam tops. Monument projects 24" above ground. Cap stamped:
Recovered OBT's -
Tamarack stump 9" N 81 1/2° W, 15.5 links, rotted badly.
W. Pine Stump 26" N 8° W, 6 links, parts of stump still standing. No scribing visible.

2
1 1/4
11

Description of monument and accessories I established to perpetuate the original location of this corner.

As pipe was recovered in good condition, it was left in place as recovered.

Added "T36N R10E" to the stamping on cap.
Marked NBT's -
W. Birch 10", S 66° E, 34.1 links
W. Birch 8", N 2° W, 14.5 links
W. Birch 10", S 36° E, 61.8 links
W. Birch 8", N 14° E, 45.1 links

Dated at Rhinelander, Wis., this 9th day of October, 1978

Signature Phillip T. Hansen Title Registered Land Surveyor Registration No. S-498
(County Surveyor, Registered Land Surveyor, or other duly authorized official)

Office of Register of Deeds, County of Oneida
Instrument was filed in this office for record on the 18th day of October, 1978
at 1:50 o'clock P. M.

Dorcas Verage Kreher
(Register of Deeds)

By: _____ Deputy

3610020020