CERTIFIED LAND CORNER RESTORATION

Index No. D-21

State of Wisconsin
County of [illegible] } ss.

I [illegible], do hereby certify that on the [illegible] day of [illegible], 1977, I found evidence of the [illegible] corner of [illegible] Township 36, North, Range 10 East, Fourth Principal Meridian, as described hereon; and that from this evidence I established a new monument and accessories as described hereon to perpetuate the original location of this corner.

Resident witnesses:

[illegible]

[illegible]

[illegible]

WISCONSIN PHILIP T. HANSEN WIS. S-498 COUNTY SURVEYOR

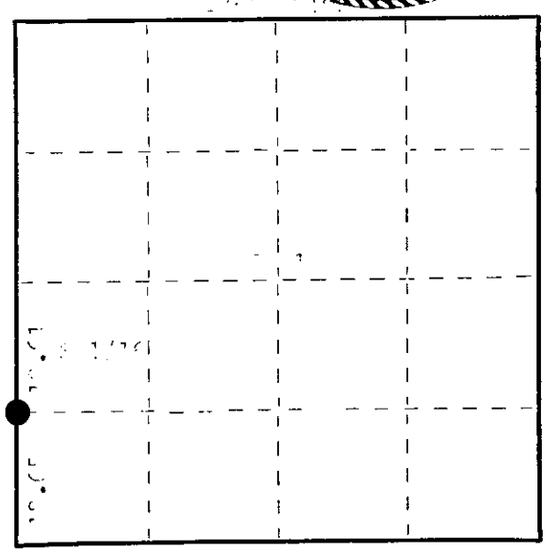

○ = Corner monument restored.

History of original corner establishment:

[illegible]

Description of corner evidence found:

[illegible]

Description of monument and accessories I established to perpetuate the original location of this corner.

[illegible]

Dated at [illegible], Wis., this [illegible] day of [illegible], 1977

Signature Philip T. Hansen Title [illegible] Registration No. [illegible]
(County Surveyor, Registered Land Surveyor, or other duly authorized official)

Office of Register of Deeds, County of [illegible], I hereby certify that the within instrument was filed in this office for record on the 22nd day of December, 1977 at 2:00 o'clock P. M.

Doris Verage Kuehn
(Register of Deeds)

By Joseph M. Boomer Deputy

FORM 985 N. C. MILLER CO., MILWAUKEE

361002 1000