

CERTIFIED LAND CORNER RESTORATION

Index No. **D-15**

State of Wisconsin } ss.

County of Oneida

I Philip T. Hansen, do hereby

certify that on the 19th day of August, 1975, I found

evidence of the SC-1/16 corner of the Section 3



Township 36N North, Range 10 East, Fourth Principal Meridian,

as described hereon; and that from this evidence I established a new monument and accessories as described hereon to perpetuate the original location of this corner.

Resident witnesses:

Glen Barker

Jim Claflin

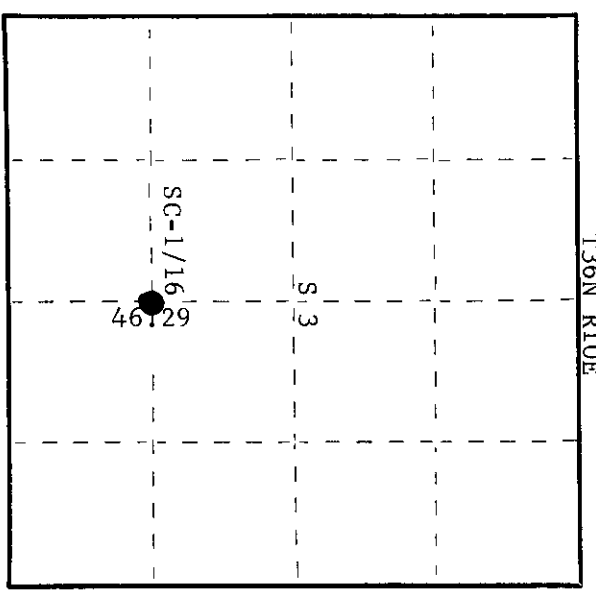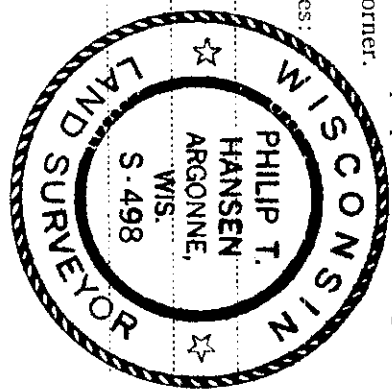

○ = Corner monument restored.

History of original corner establishment:

Corner established by D.H. Vaughan, County Surveyor, in 1906 from which spruce pine 9" bears N58°E, 8 links and spruce pine 14" bears S35°W, 34 links. Corner recovered by H.C. Lawrence, Registered Land Surveyor, in 1946. Set new post but no new BT's. Set cedar post, scribed BT, in center of Vaughan's old BT stump (spruce pine) 14" S35°W, 34 links.

Description of corner evidence found:

Corner recovered 1-1/2" iron pipe stuck in old post hole. No evidence of Lawrence's cedar post found. Cedar post set in Vaughan's old spruce pine stump still intact. Measurement and bearing to iron pipe checks out perfect.

BT's: Spruce pine 9" S58°E 8 links-now a decayed mound
Spruce pine 14" S35°W 34 links-a decayed stump scribed post still intact

3610031020

Description of monument and accessories I established to perpetuate the original location of this corner.

Replaced iron pipe with 1-1/2" OD iron pipe w/2" brass cap stamped -

NBT's: Jack pine 7" N37°W 63.4 links-scribed 1/16 BT
Jack pine 10" S10°W 13.3 links-scribed 1/16 BT

S498
T36N R10E
SC-1/16 S/3
CPT-1975

Dated at Rhineland, Wis., this 3rd day of September, 1975.

Signature *Philip T. Hansen* Title Registered Land Surveyor Registration No. S-498
(County Surveyor, Registered Land Surveyor, or other duly authorized official)

Office of Register of Deeds, County of Oneida
Instrument was filed in this office for record on the 14th day of October, 1975 at 2:00 o'clock P.M.

Dennis George Fisher
(Register of Deeds)

By _____ Deputy