

CERTIFIED LAND CORNER RESTORATION

Index No. C-16



State of Wisconsin

County of Oneida } ss.

I Philip T. Hansen 14th, do hereby certify that on the 19 75 day of August 19 75, I found evidence of the EC-1/16 corner of Section 3 36 Township 10 East, North, Range 10 East, Fourth Principal Meridian.

as described hereon; and that from this evidence I established a new monument and accessories as described hereon to perpetuate the original location of this corner.

Resident witnesses:

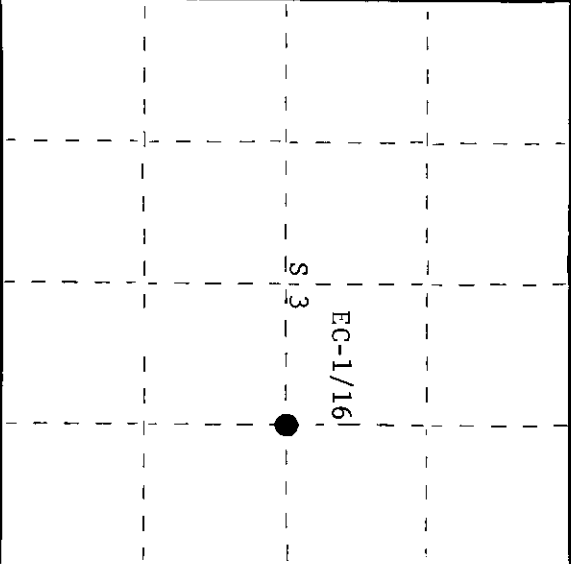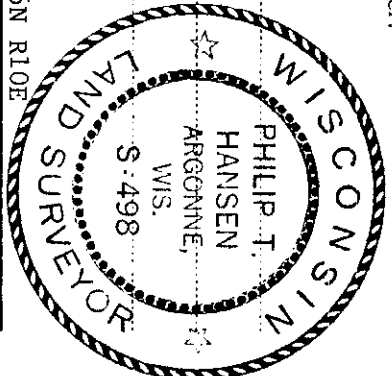

○ = Corner monument restored.

CERTIFIED LAND CORNER RESTORATION

History of original corner establishment:

Corner established by D.H. Vaughan, County Surveyor, in 1906. Established BT's: Tamarack 10" N45°E 16.5 links and Tamarack 7" N85°W 26 links. Corner recovered and restored by H.C. Lawrence, Registered Land Surveyor, in 1946. Recovered Vaughan's N-1/16 corner in fence corner. Also recovered his tamarack 10" N45°E, 16.5 links, but the tamarack 7" had been destroyed by road construction. Set new 3" cedar post and marked Norway pine 12" N20°W, 29.5 links, Norway pine 16" N63°W, 24 links.

Description of corner evidence found:

Recovered Lawrence's 3" cedar post, squared and scribed EC-1/16 S3 in very poor condition. Also recovered OBTTs: Norway pine 12" N20°W, 29 links, now a cutoff stump, and Norway pine N63°W, 24 links, now a stump. Jack pine 10" N80°W, 11 links, now a 12' stub.

Description of monument and accessories I established to perpetuate the original location of this corner.

Replaced 3" cedar post with 1-1/2 OD iron pipe w/2" brass cap stamped - S498 T36N R10E

NBT: Red maple 6" N5°E 111.5 links-scribed 1/16 BT

This area has been clear-cut and no other trees available for BT's. EC-1/16 S3 CPI-1975

Dated at Rhineland, Wis., this 8th day of September, 19 75.

Signature Philip T. Hansen Title Registered Land Surveyor Registration No. S-498
(County Surveyor, Registered Land Surveyor, or other duly authorized official)

Office of Register of Deeds, County of Oneida 14th day of October 19 75
at 2:00 o'clock P. M. hereby certify that the within

Dennis Tenager Kuehn
(Register of Deeds)

By _____ Deputy

3610032010