

CERTIFIED LAND CORNER RESTORATION

Index No. **C-15**

State of Wisconsin



County of Oneida } ss.

I, Philip T. Hansen, do hereby certify that on the 9th day of May, 1975, I found evidence of the C-1/4 corner of Section 3

Township 36 North, Range 10 East, Fourth Principal Meridian,

as described hereon; and that from this evidence I established a new monument and accessories as described hereon to perpetuate the original location of this corner.

Resident witnesses:

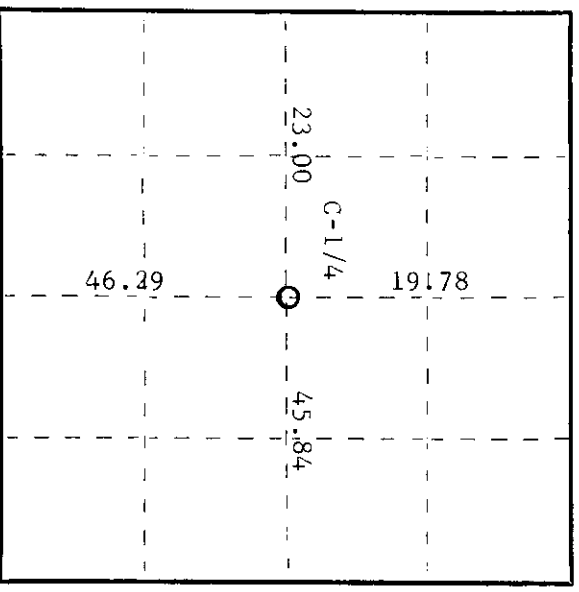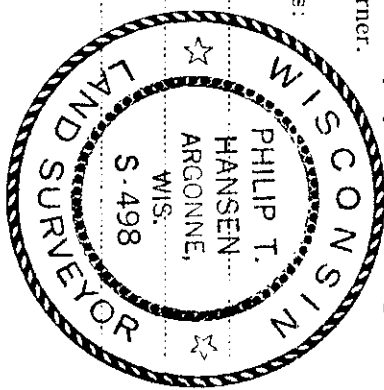

○ = Corner monument restored.

History of original corner establishment:


Original corner established by D.H. Vaughan, County Surveyor, in 1906, from which yellow pine 20" bears N87 $\frac{3}{4}$ °E 46 $\frac{1}{2}$ links, and white pine 8" bears S49 $\frac{1}{2}$ °W 14 links. Corner recovered by H.C. Lawrence, Registered Land Surveyor, in 1947, during his retracement survey. Set a new 4" squared post from Vaughan's BT's and established NBT's. Norway pine 16" S35°W 24 links.

Description of corner evidence found:

- Recovered H.C. Lawrence's 4" cedar post, squared and scribed C $\frac{1}{2}$ S3, in poor condition.
- Recovered Vaughan's pine stump N87°30'E 46.5 links, decayed and scribing not visible.
- Recovered Lawrence's red pine 16" (17") S35°W (S39°W) 24 links, scribed C $\frac{1}{2}$ NBT.

Description of monument and accessories I established to perpetuate the original location of this corner.

- Replaced Lawrence's 4" cedar post with 2 $\frac{1}{2}$ " iron pipe with brass cap stamped - S498
- Established NBT - red pine 18" N88°W 56.2 links, scribed $\frac{1}{4}$ BT.

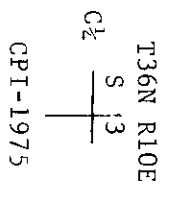

Dated at Rhineclander, Wis., this 7th day of July, 1975.

Signature *Philip T. Hansen* Title Registered Land Surveyor Registration No. S-498
County Surveyor, Registered Land Surveyor, or other duly authorized official

Office of Register of Deeds, County of Oneida
Instrument was filed in this office for record on the 1st day of October, 1975
at 3:00 o'clock P.M.

Dora Virginia Kuehn
Register of Deeds

By: Deputy

3610032020