

CERTIFIED LAND CORNER RESTORATION



Index No. **C-13**

State of Wisconsin

County of Oneida } ss.

I Phillip T. Hansen, do hereby certify that on the 18th day of August, 1975, I found evidence of the Quarter corner of Sections 3 and 4 Township 36, North, Range 10 East, Fourth Principal Meridian, as described hereon; and that from this evidence I established a new monument and accessories as described hereon to perpetuate the original location of this corner.

Resident witnesses:
 Glen Barker
 Jim Clarlin

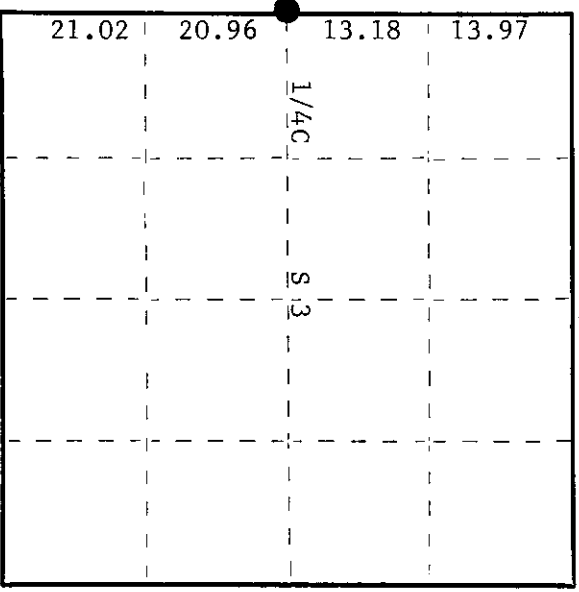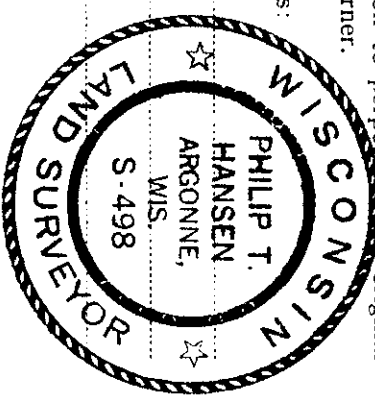

○ = Corner monument restored.

History of original corner establishment:

Corner recovered and restored by D.H. Vaughan, County Surveyor, in 1906. Recovered original BT's: Yellow pine 10" N86°W, 317 links and white pine 20" N86-1/2°E, 269 links. Corner recovered by H.C. Lawrence, Registered Land Surveyor, during his retracement survey of 1946. Recovered remnants of old post and BT's. Stumps well preserved and marks plain.

Description of corner evidence found:

Recovered part of H.C. Lawrence's cedar post lying in marsh grass. The old cedar point buried in the muck with a flat iron rod driven in beside it. Recovered white pine stump 20" N86°30'E, 269 links (original BT). Top scribing partly gone. Bottom BT scribing good. This sits on the east side of a small creek.

Description of monument and accessories I established to perpetuate the original location of this corner.

Replaced flat iron rod and cedar point with 2-1/2" iron pipe w/brass cap stamped -

S498
T36N R10E

As this corner sits in an open marsh, established two witness marks:
 1-1/2" iron pipe w/2" brass cap, 50 links south stamped W.C. S50 links
 1-1/2" iron pipe w/2" brass cap, 40 links east stamped W.C. E40 links

1/4 S4/S3
CPT-1975

Dated at Rhinelander, Wis., this 3rd day of September, 1975.

Signature Phillip T. Hansen Title Registered Land Surveyor Registration No. S-498
 (County Surveyor, Registered Land Surveyor, or other duly authorized official)

Office of Register of Deeds, County of Oneida at 2:00 o'clock P. M. 14th day of October 1975
 I hereby certify that the within instrument was filed in this office for record on the

Dennis Lange Jucker
 Register of Deeds

By: _____ Deputy

3610042000