


# U.S. PUBLIC LAND SURVEY MONUMENT RECORD

**Note:** This form is intended and designed to fulfill all requirements of Wisconsin Administrative Code, Chapter A-E 7.08 U.S. Public Land Survey Monument Record (3) (a) (b) (c) (d) (e) (f) (g) (h) (i). An additional sheet may be added if necessary to conform with said requirements.

(a) Corner location: Township 36 North  
 Range 10 East/West

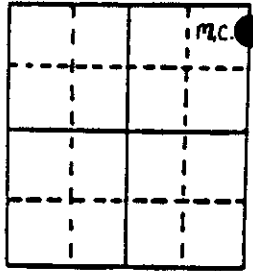

Section 5

Town/City/Village Pelican  
 County Oneida

(b) (f) (g) (h) Description of monument found at this corner and if it was accepted, state all evidence (material, testimonial, occupational, plats, records, other monuments) used as a basis for accepting. If not accepted or if nothing was found, state evidence used as basis for establishing location. If reestablished through lost corner proportionate methods, indicate all monuments, distances and directions used to establish. Indicate type of monument found or set and sign post.

- 1863 Daugherty 59 ch. set M.C. Cedar 10" N 77 E 14 lks.  
 Birch 10" S 17 W 16 lks.
- 1950 Abernathy found I.P. and Cedar 10" S 72 E 0.66', N.P. 14" N 26 W 24.16'
- 1968 Kirby found I.P.
- 1989 W.E. Badow found I.P. and replaced it with Oneida County Monument  
 witnessed as shown below. W. Post East 2'.

(c) (d) (e) Plan view of corner with ties to at least 4 witness monuments. If in disagreement with previously established corner, show the distances between the two corners and also indicate the ties to the disputed corner.

**NOTE**

MEASUREMENTS TAKEN FROM  
 6" SPIKES IN SIDE OF TREES

BEARINGS TAKEN WITH  
 HANDHELD MAGNETIC  
 COMPASS


NO SCALE

**REGISTER OF DEEDS OFFICE  
 ONEIDA COUNTY, WIS.**

FILED

FEB 7 1991

At O'Clock M  
**THOMAS H. LEIGHTON**  
 REGISTER OF DEEDS

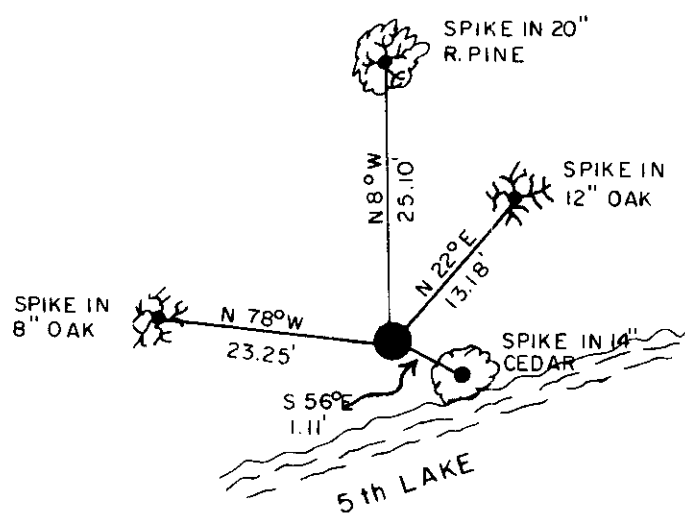

(i) I, William E. Badow  
 (type or print name) certify that the corner location on this record was determined by me or under my direction and control and that this U.S. Public Land Survey Monument Record is correct and complete to the best of my knowledge and belief.

William E. Badow 2-1-91  
 Signature Date



Index No. AB-9

3610053600