

This form is intended to fulfill the requirements of Chapter A-E 7.08 (3)(a) thru (i) U.S. Public Land Survey Monument Location Record, Wisconsin Administrative Code. Use the reverse side of form for continuation.

U.S. PUBLIC LAND SURVEY MONUMENT LOCATION RECORD

Recorders Data

USPLS CORNER: NW SECTION CORNER SECTION: 16 TOWNSHIP: 36 NORTH RANGE: 10 EAST

NAME OF WATERWAY FOR M.C. CORNER: N/A SECTION LINE: N/A

(CITY)(VILLAGE)(TOWN) OF: PELICAN COUNTY OF: ONEIDA

Description of monument found or placed and all other evidence used as the basis for monument location; including monuments and related measurements required if the corner location was reestablished by lost corner proportionate methods. Also indicate name of original surveyor, original survey date and the corner monument, bearing trees, witness or other reference monuments established; including measured bearing and distance ties, from available records.

Found loose and tipped older 2" dia. galvanized iron pipe painted blue with stamped brass cap 33" high in a cairn of moss covered large rocks at grade. I replumbed and resecured the iron pipe with cairn rocks for new ties; could not deepen the iron pipe due to below grade refusal. A blue tree painted and blaze orange flagged survey line runs East and also West to Claussen Road; and an older cleared survey line also leads North to Clausenn Road. A 6" Tamarack with Nepco aluminum locator tag on upper face also about 40' North of corner. Corner falls in a higher "island" in a large wooded wetland area.


In August 1863, William E. Daugherty/GLO set a wood post as the original corner and marked new OBTs: a 10" Pj S82°E 70 links and a 6" Bw S14°E 38.5 links; all now obliterated.

In May 1954, Ivan Branham/RLS 236 notes an iron pipe with brass cap at this corner per Plat of Survey L-1277 in Oneida County survey records.

In October 1998, Glen Barker/RLS 1682 notes he found 1.75" dia. iron pipe with brass cap at this corner per Plat of Survey B-4034 in Oneida County survey records.

This recovery completed October 18, 2001; there were no direct witnesses.

Plan view map of monument location with bearing and distance ties to a minimum of four(4) described witness or reference monuments of concrete, natural stone, iron, live bearing trees or equivalent material. If applicable, also show a minimum of two(2) bearing and distance ties to any other monument found and not accepted; including the bearing and distance from the accepted monument.

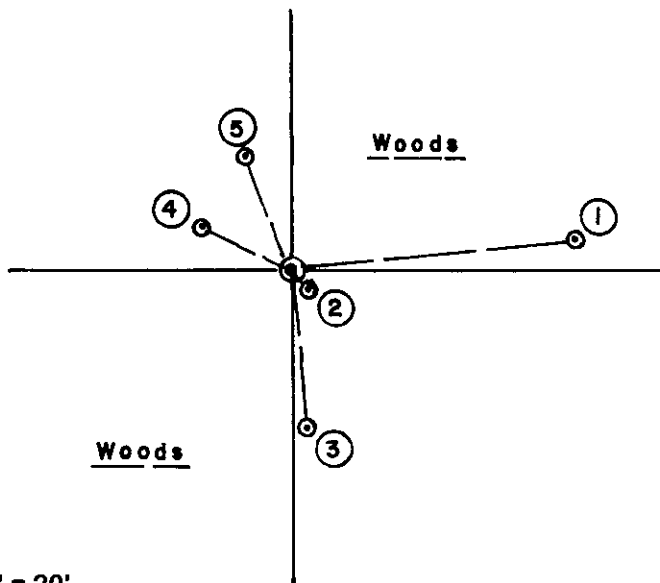

WITNESS MONUMENT TIES:


- ① - New BT 6.5" Tamarack N84°E at 29.43'.
- ② - Older BT 6.5" Tamarack with Nepco locator tag on upper face at S39°E 2.81'.
- ③ - New BT 6" Tamarack S06°E at 16.93'.
- ④ - New BT 8" Tamarack N64°W at 10.43'.
- ⑤ - New BT 8.5" Tamarack N22°W at 12.50'.

Standard white poly 'T' corner marker post set 1.5' East of corner monument.

SCALE: 1" = 20'

Unless otherwise indicated, all bearing tree ties are to a .25" dia. by 2.5" long PK nail with a 1.25" dia. steel washer driven into unblazed right face and a .25" dia. by 2.5" long PK nail with a 2" dia. steel washer stamped BT is also driven into unblazed face of bearing tree at DBH; the basis for measured bearings is by compass to nearest degree and all tie distances are measured horizontal by steel tape corrected to nearest 1/100th feet at standard temperature of 68° F.


RLS SEAL:

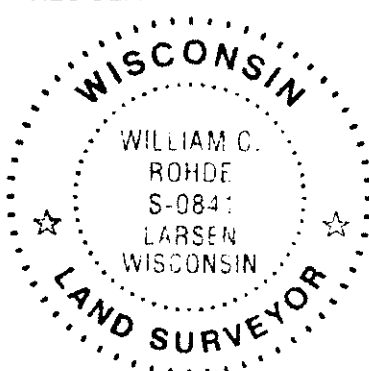

LAND SURVEYOR CERTIFICATE:

I, William C. Rohde, hereby certify that I am duly licensed as a Professional Land Surveyor in the State of Wisconsin; that this USPLS monument location was determined by me and/or under my direct supervision and control; and that this U.S. Public Land Survey Monument Location Record is true and correct to the best of my knowledge and belief.

Signed: *William C. Rohde*
 William C. Rohde RLS 841

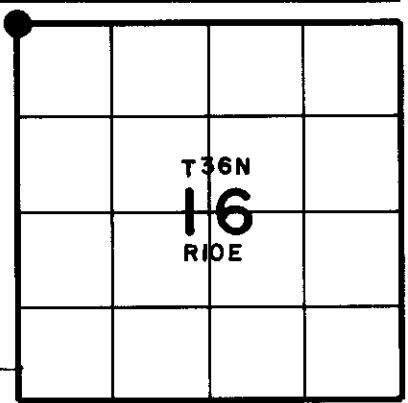

SECTION LOCATION MAP

INDEX NO. J 9

William C. Rohde