


# U.S. PUBLIC LAND SURVEY MONUMENT RECORD

**Note:** This form is intended and designed to fulfill all requirements of Wisconsin Administrative Code, Chapter A-E 7.08 U.S. Public Land Survey Monument Record (3) (a) (b) (c) (d) (e) (f) (g) (h) (i). An additional sheet may be added if necessary to conform with said requirements.

(a) Corner location: Township 36 North  
 Range 10 East/West

Town/City/Village MONICO

County ONEIDA

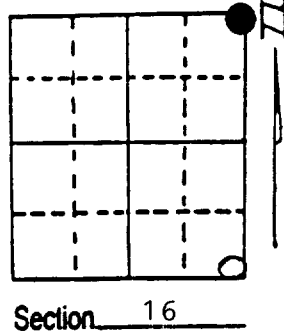

(b) (f) (g) (h) Description of monument found at this corner and if it was accepted, state all evidence (material, testimonial, occupational, plats, records, other monuments) used as a basis for accepting. If not accepted or if nothing was found, state evidence used as basis for establishing location. If reestablished through lost corner proportionate methods, indicate all monuments, distances and directions used to establish. Indicate type of monument found or set and sign post.

ORIGINAL CORNER ESTABLISHED BY WILLIAM E. DAUGHERTY, GOVERNMENT DEPUTY SURVEYOR IN 1863.  
 TAMARACK 8" S45E 14 LKS. - TAMARACK 10" N40W 43 LKS.

IN OCTOBER 1902 B.F. DORR SET A CORNER BY DOUBLE PROPORTION AND MARKED NEW B.T.'S A B.W. N40W 22 LKS. AND A 9" HEMLOCK S65W 36 LKS.

IN 1917 D.H. VANGHAN FOUND POST SET BY DORR. B.T.'S DEAD AND BURNED. NO SUITABLE B.T.'S

IN 1947 H.C. LAWRENCE RAN SOUTH BETWEEN SECTIONS 9 AND 10 FROM QUARTER SECTION CORNER. FOUND OLD POST FOR S 1/16 AND A LOCATION POST WITH TAG ON THE NORTH SIDE OF OLD FIRE LANE 15' OF CENTER LINE. NO EVIDENCE OF SECTION CORNER. REESTABLISHED SECTION CORNER BY RETRACING D.H. VAUGHAN SURVEY IN 1917 AND H.C. LAWRENCE'S IN 1947. (OVER)

(c) (d) (e) Plan view of corner with ties to at least 4 witness monuments. If in disagreement with previously established corner, show the distances between the two corners and also indicate the ties to the disputed corner.

SET A 2' 1/2" ALUMINUM PIPE WITH 3" ALLOY CAP  
 STAMPED

ONEIDA COUNTY

T36N R10E

MARKED B.T.'S

JACK PINE 10"	S30E	33.27'	1986
JACK PINE 10"	S12W	33.34'	1986
JACK PINE 10"	S70W	36.74'	1986

S 9	S10
S 16	S15

BLACK SPRUCE 8" N60W 58.31 2002

1682  
 1986

MONUMENT 6" ABOVE GROUND

NOTE:

THE CORNER RESTORATION SHEET OF THIS CORNER WAS LOST IN PROCESSING. RECENTLY, IT WAS DISCOVERED. THE DOCUMENT WAS NOT RECORDED.

(i) I, GLEN BARKER  
 (type or print name) certify that the corner location on this record was determined by me or under my direction and control and that this U.S. Public Land Survey Monument Record is correct and complete to the best of my knowledge and belief.

Glen Barker 12-22-03  
 Signature Date



3610090000  
 Stamp

Index No. 5-13

RAN FROM QUARTER SECTION CORNER BETWEEN SECTIONS 9 AND 10 TO  
S 1/16 CORNER POSITION RECOVERED FROM H.C. LAWRENCE'S  
FIELD NOTES. D.H. VAUGHAN'S RECORDED DISTANCE WAS 21.17 CHAINS  
(1397.22'). WE RECORDED A DISTANCE OF 21.21 CHAINS (1399.51').  
ON THIS LINE WE SET THE SECTION CORNER AT VAUGHAN'S RECORDED  
DISTANCE OF 42.34 CHAINS (2794.44'). A BEARING OF S05° 02' 08" W  
SET SECTION CORNER ON ADJUSTED DISTANCE OF 42.33 CHAINS (2793.53').

RECOVERED OLD LOCATION POST AND TAG ON THE NORTH SIDE OF OLD  
FIRE LANE, WHICH LAWRENCE'S NOTES STATES THE SECTION CORNER HAS  
BEEN CONSIDERED TO BE SOUTH OF LOCATION POST 1.90 CHAINS (125.4').  
REESTABLISHED CORNER IS 2.06 CHAINS (136.0').

