

CERTIFIED LAND CORNER RESTORATION

Index No. **G-13**

State of Wisconsin

County of Oneida } ss.


I Phillip T. Hansen, do hereby certify that on the 5th day of October, 1978, I found evidence of the Quarter corner of Sections 9 & 10 Township 36, North, Range 10 East, Fourth Principal Meridian, as described hereon; and that from this evidence I established a new monument and accessories as described hereon to perpetuate the original location of this corner.

Resident witnesses:


Glen Barker

Jim Claflin

Herb Wagoner

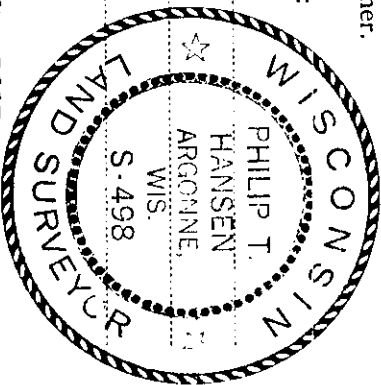


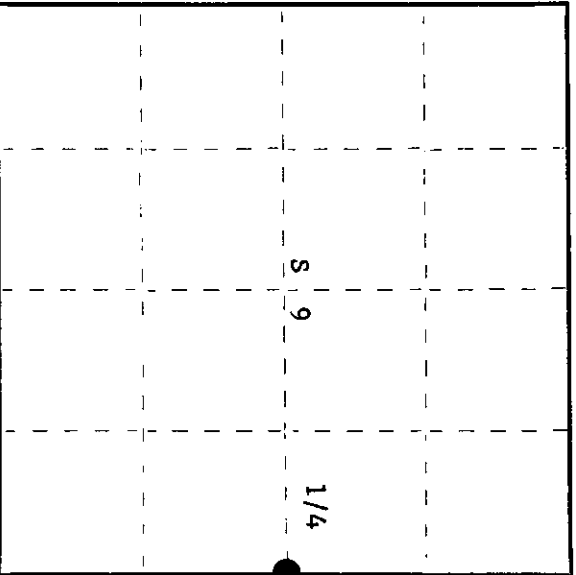

○ = Corner monument restored.

History of original corner establishment: Original Corner established by Wm. E. Dougherty, Deputy Surveyor, in 1863, from which white pine 15" bears S89°W, 9 links and white pine 12" bears N77°E, 85 links. Corner recovered by D.H. Vaughan, County Surveyor, in 1917.

Corner recovered by H.C. Lawrence, Registered Land Surveyor, in 1947. Found an old post and stump of original white pine N83°W, 9 links. Set a new post and marked NBT's - Spruce Pine 16" N29°E, 4 1/2 links; Spruce Pine stump 12" S48°W, 25 links. Marked a NBT in 1959, White Birch 10" S45°E, 27 1/2 links.

Description of corner evidence found:

Recovered Lawrence's 5" squared cedar post scribed 1/4S S9 1/4S S10 and another old 4" squared cedar post laying beside it. Recovered Nekoosa's 1-3/4" iron pipe with screw-in brass cap stamped:

Monument projects 18" above ground. Rock calrn around base.  
Recovered original white pine stump N83°W, 9 links, bottom facing still legible. Spruce Pine N29°E, 4.5 links, now a cut off stump; White Birch 10" (12") S45°E, 27.5 links, scribed 1/4S NBT. T36N S 9 1/4 10 R10E

Description of monument and accessories I established to perpetuate the original location of this corner.

As Nekoosa's iron pipe was recovered in perfect condition, it was left in place as recovered.

Marked NBT's -

- Jack Pine 8" N17°E, 49.8 links
- Jack Pine 6" S72°W, 45.5 links
- W. Birch 10" N63°E, 58.2 links
- all scribed 1/4 BT

Dated at Rhinelander, Wis., this 9th day of October, 1978

Signature Phillip T. Hansen Title Registered Land Surveyor Registration No. S-498  
(County Surveyor, Registered Land Surveyor, or other duly authorized official)

Office of Register of Deeds, County of Oneida 1854 day of October 1978  
Instrument was filed in this office for record on the 1854 day of October 1978  
at 1:50 o'clock P M.

Louis Bergey Kreber  
(Register of Deeds)

By Phillip T. Hansen Deputy

3610092000