

CERTIFIED LAND CORNER RESTORATION



Index No. J-19

State of Wisconsin

County of Oneida } ss.

I, Phillip T. Hansen, do hereby certify that on the 20th day of June, 1979, I found evidence of the Quarter corner of Sections 11 and 14 Township 36, North, Range 10, East, Fourth Principal Meridian, as described hereon; and that from this evidence I established a new monument and accessories as described hereon to perpetuate the original location of this corner.

Resident witnesses:
Glen Barker
Jim Clafflin
Herb Wagoner

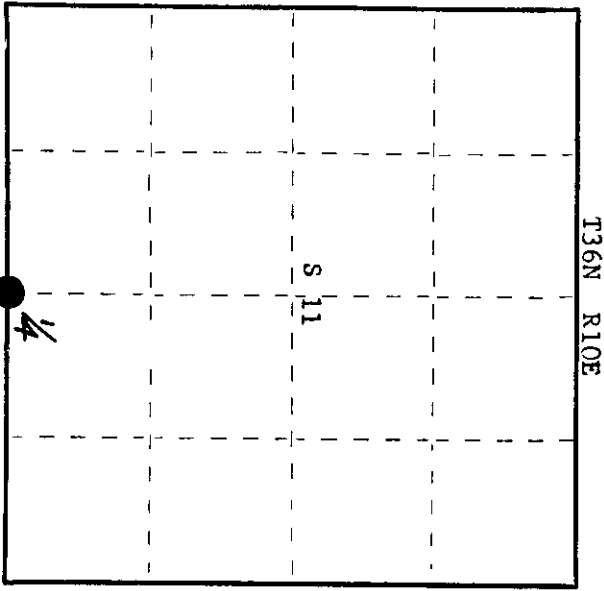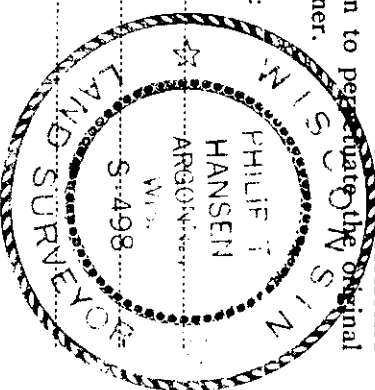

○ = Corner monument restored.

History of original corner establishment:

Original corner established by Wm. E. Dougherty, Deputy Surveyor, in 1863, from which Flr 8" bears N10°E 8 links and Birch 10" bears S27°W 13 links. Corner recovered by D.A. Vaughan, County surveyor, in 1900. Marked NBT's - Tamarack 9" N81°W 15-1/2 links and Y.Pine 26" N8°W. These BT's are the same trees as given at S 1/4 corner. H.C. Lawrence, Registered Land Surveyor, recovered an old post in 1951. Notes state that no BT's were recovered.

Description of corner evidence found:

Recovered a very old 4" squared tamarack post, rotted but still standing. Scribe marks 1/4S and S14 still visible.

Recovered OBT's -

- Tamarack stub, 5' high, 4" diameter 55°E 28.9 links
- Tamarack stump 4" N49°E 2.5 links, scribe marks 1/4 BT are still visible on both BT's.

Description of monument and accessories I established to perpetuate the original location of this corner.

Replaced old post with 2-1/2" Berntsen A-1 Federal Monument, projecting 24" above ground. Cap stamped:

- Marked NBT's - Tamarack 14" N74°W 65.9 links S498 - 1979
- Tamarack 9" N54°W 65.4 links T36N R10E
- Tamarack 10" N34°W 66.6 links 1/4 S 11
- all scribed 1/4 BT S 11
- 1/4 S 11

Dated at Rhineland, Wis., this 26th day of June, 1979.

Signature Phillip T. Hansen Title Registered Land Surveyor Registration No. S-498
(County Surveyor, Registered Land Surveyor, or other duly authorized official)

Office of Register of Deeds, County of Oneida, I hereby certify that the within instrument was filed in this office for record on the 7th day of July, 1979 at 100 o'clock P. M.

Dorcas Wagoner
(Register of Deeds)

By: _____ Deputy

3610110020