

CERTIFIED LAND CORNER RESTORATION

Index No. F-21

State of Wisconsin

County of Oneida } ss.



I, Phillip T. Hansen, do hereby certify that on the 12th day of January, 1979, I found evidence of the N 1/16 corner of Section 11 and 12 Township 36, North, Range 10 East, Fourth Principal Meridian, as described hereon; and that from this evidence I established a new monument and accessories as described hereon to perpetuate the original location of this corner.

Resident witnesses:

Glen Barker

Jim Clafin

Herb Wagoner

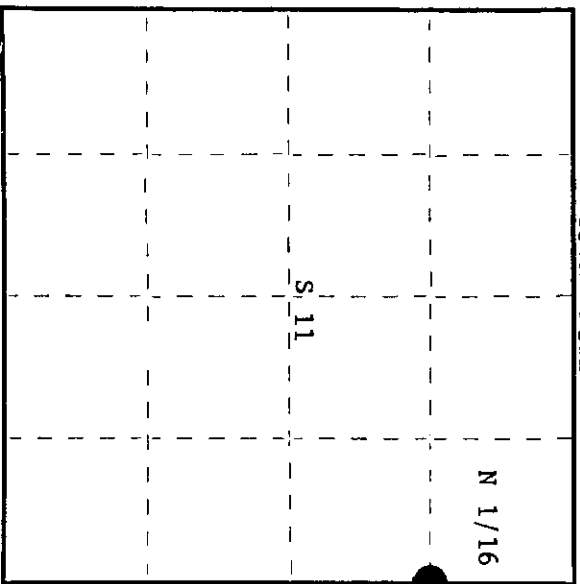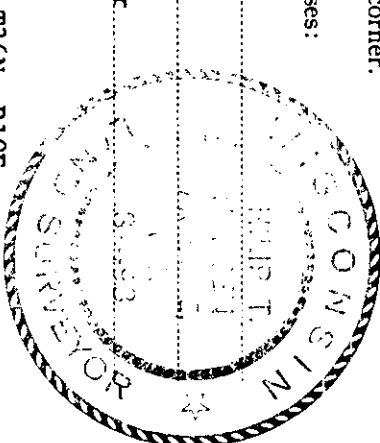

○ = Corner monument restored.

History of original corner establishment:

Original corner established by D.H. Vaughan, County surveyor, in 1900. Marked BT's - Tamarrack 10" S42°E 24 links and Cedar 6" N5°W 23½ links. H.C. Lawrence, Registered Land Surveyor, recovered Vaughan's old post intact. Recovered OBT's - Tamarrack 10" S42°E 24 links and Cedar 6" N5°W 23½ links. Set new cedar post and marked NBT's - Cedar 10" S20°W 20 links and White Birch 10" S20°E 10 links.

Description of corner evidence found:

Recovered H.C. Lawrence's 6" squared cedar post, scribed N 1/16 S11, N 1/16 S12, standing in poor condition. Also found point of Vaughan's old post beside it.  
Recovered OBT's -  
Cedar 10" S20°W 20 links, scribed S11, 1/8 BT.  
W. Birch 10" S20°E 10 links, now a cut-off stump.

Description of monument and accessories I established to perpetuate the original location of this corner.

Replaced cedar post with 1½" iron pipe with 2" brass cap, stamped:  
Monument projects 24" above ground.  
Marked NBT -  
Cedar 10" N11°W 42.2 links, scribed 1/16 BT.

S498  
T36N R10E  
N 1/16 11+12  
CPI-1979

Dated at Rhinelander, Wis., this 18th day of January, 1979

Signature Phillip T. Hansen, Title Registered Land Surveyor Registration No. S-498  
(County Surveyor, Registered Land Surveyor, or other duly authorized official)

Office of Register of Deeds, County of Oneida, I hereby certify that the within instrument was filed in this office for record on the 31st day of January, 1979 at 2:30 o'clock P. M.

Donna W. Hagg  
(Register of Deeds)

By: \_\_\_\_\_ Deputy

3610113000