

CERTIFIED LAND CORNER RESTORATION

Index No. **J-25**

State of Wisconsin

County of Oneida } ss.


I Phillip T. Hansen, do hereby certify that on the 11th day of July, 1975, I found evidence of the Section corner of 12, 7, 18, and 13

Township 36, North, Range 10 and 11 East, Fourth Principal Meridian,

as described hereon; and that from this evidence I established a new monument and accessories as described hereon to perpetuate the original location of this corner.

Resident witnesses:

Glen Barker
Jim Claitor

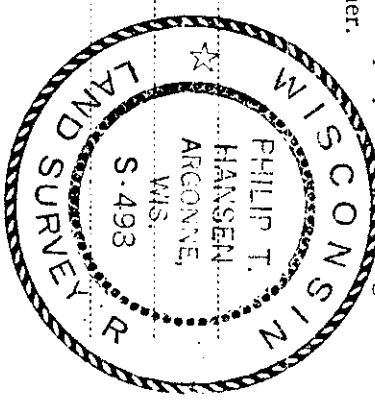


History of original corner establishment:
Original corner established by Hiram C. Fellows, Government Deputy Surveyor, in 1859 from which tamarack 8" bears S60°W, 76 links; spruce 8" bears N4°W, 82 links; tamarack 8" bears N76°E, 78 links; and tamarack 8" bears S84°E, 141 links.
Corner recovered by H.C. Lawrence, Registered Land Surveyor, in 1951. He found Vaughan's old wooden post and a 2½" iron pipe with brass cap. Distance from established E-1/4 corner was 40.22 chains. Recovered old tamarack 15", N11°W, 21 links.

Description of corner evidence found:
Recovered 2½" iron pipe with brass cap in good condition. Found pieces of old cedar post lying beside it and some evidence of old stake in the muck along side.
Recovered 0BT tamarack 15", N11°W, 21 links. This had rotted off and was lying on the ground. Rolled it over and found scribing T36N, R10E, S12.

Description of monument and accessories I established to perpetuate the original location of this corner.
Stamped brass cap -

Marked NBT's - Black spruce 6" S28°W 18.7 links R 12/7 R
Black spruce 7" S22°E 41.9 links 10 13/18 11
Both scribed SC BT. E 1975

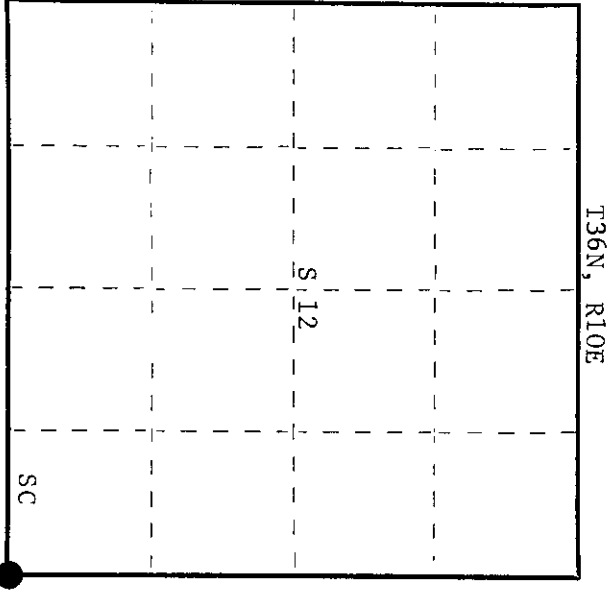

○ = Corner monument restored.

Dated at Rhineland, Wis., this 22nd day of August, 1975.

Signature Phillip T. Hansen Title Registered Land Surveyor Registration No. S-498
(County Surveyor, Registered Land Surveyor, or other duly authorized official)

Office of Register of Deeds, County of Oneida
Instrument was filed in this office for record on the 14th day of October 1975 at 2:00 o'clock P. M.

Doris Savage Parker
(Register of Deeds)

By: _____ Deputy

3610120000