

CERTIFIED LAND CORNER RESTORATION

Index No. J-23

State of Wisconsin

County of Oneida

ss.

I Phillip T. Hansen

do hereby certify that on the 21st day

of December, 1976, I found

evidence of the Quarter

corner of Section 12 & 13

Township 36, North, Range

10 East, Fourth Principal Meridian,


as described hereon; and that from this evidence I established a new monument and accessories as described hereon to perpetuate the original location of this corner.

Resident witnesses:


Glen Barker

Jim Clark in

Herb Wagoner

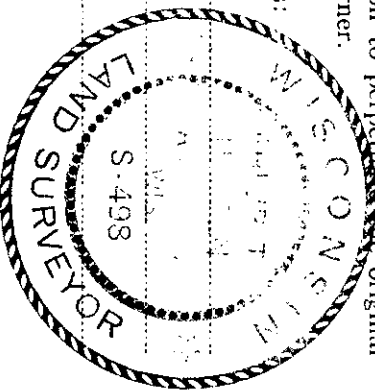

T36N R10E

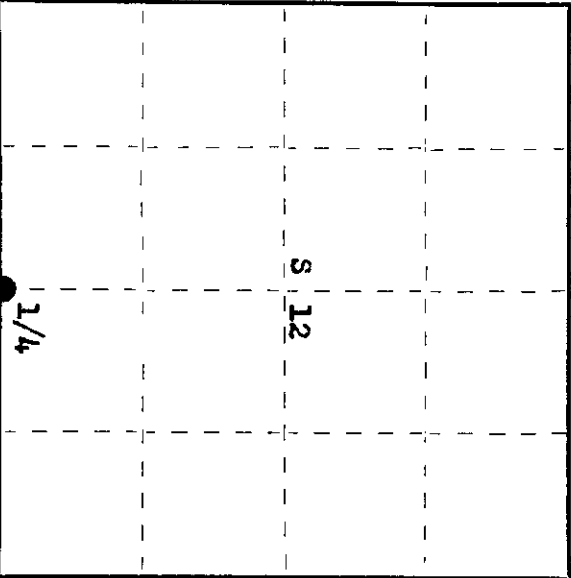

○ = Corner monument restored.

History of original corner establishment:

Corner established by Hiram C. Fellows, Deputy Surveyor, in 1859 from which Tamarack 10" bears N 60° W 36 links and Tamarack 6" bears S 70° E 43 links.

Corner recovered by D.H. Vaughan, County surveyor, in 1900. Marked NBTs - Tamarack 12" S 5° W 28 links and Tamarack 14" N 40° E 21 links.

Corner recovered by H.C. Lawrence, Registered Land Surveyor, in 1951. Set new post and marked NBTs - Cedar 14" N 3° E 62.5 links and Cedar 10" S 3° W 84 links.

Description of corner evidence found:

Recovered Lawrence's 4" cedar post, squared and scribed 1/4S S12, 1/4S S13 in poor condition.

Recovered OBTs - Vaughan's Tamarack 14" N 4° E 21 links, now a decayed stump.

H.C. Lawrence's Cedar 14" (16") N 3° E 62.5 links, scribed 1/4 S12 NBT. Cedar 10" (12") S 3° E 84 links (81.7 links).

Description of monument and accessories I established to perpetuate the original location of this corner.

Replaced 4" cedar post with 2 1/2" Bernitsen A-1 Federal Monument stamped:

Monument projects 18" above ground.

NBT - Cedar 10" S 53° E 78.8 links, scribed 1/4 BT.

T36N R10E
1/4 S12
S13
S498-1976

Dated at Rhinelander, Wis., this 5th day of January, 1977.

Signature Phillip T. Hansen Title Registered Land Surveyor Registration No. S-498
(County Surveyor, Registered Land Surveyor, or other duly authorized official)

Office of Register of Deeds, County of Oneida. I hereby certify that the within instrument was filed in this office for record on the 24th day of February, 1977 at 1:00 o'clock P. M.

Doris Berger-Kuehn
(Register of Deeds)

By: _____ Deputy

3610120020