

CERTIFIED LAND CORNER RESTORATION

Index No. J-22



State of Wisconsin

County of Oneida } ss.

I Philip T. Hansen, do hereby certify that on the 31st day of July, 1975, I found evidence of the W-1/16 corner of Sections 12 and 13 Township 36, North, Range 10 East, Fourth Principal Meridian, as described hereon; and that from this evidence I established a new monument and accessories as described hereon to perpetuate the original location of this corner.

History of original corner establishment:  
Original corner established by D.H. Vaughan, County Surveyor, in 1904 from which tamarack 24" bears S3°E, 10½ links and white pine 15" bears N50°W, 7 links.  
Corner recovered by H.C. Lawrence, Registered Land Surveyor, in 1947. Found Vaughan's old post and BT's intact. Set new post and made NBT's sugar maple 9", S20°E, 47 links and soft maple 8", S68°E, 58 links.

Resident witnesses:  
Glen Barker  
Jim Cliflin

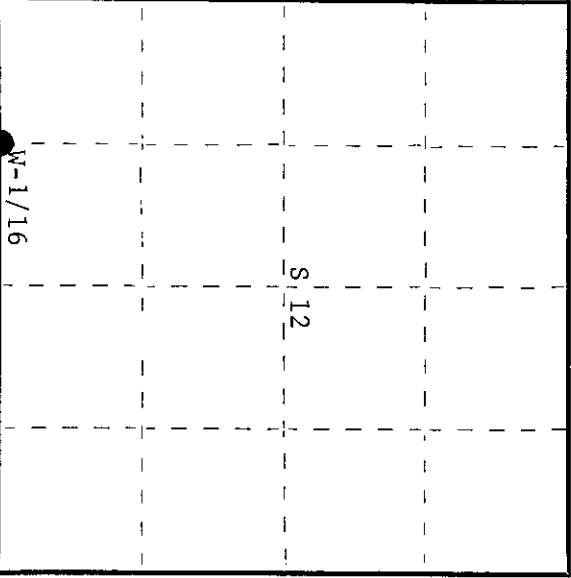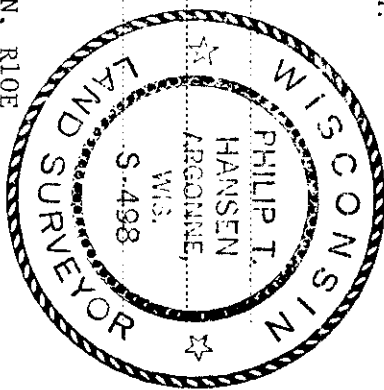

○ = Corner monument restored.

Description of corner evidence found:  
Recovered H.C. Lawrence's 4" cedar post, squared and scribed W-1/16 S12, W-1/16 S13, in fair condition.

Recovered OBT's - Tamarack 24" S3°E 10.5 links - now a decayed stump  
White pine 15" N50°W 7.0 links - now a 2' stump scribed BT  
Red maple 8" S68°E 58.0 links - now a cut-off stump  
Red maple 9" (11") S20°E (S18°E) 47.0 links - scribed W-1/16, bottom grown over

Description of monument and accessories I established to perpetuate the original location of this corner.  
Replaced 4" cedar post with 1½" OD iron pipe with 2" brass cap stamped -

NBT - White birch 8" S82°W 62.2 links scribed 1/16 BT

CPI-1975

Dated at Rhineland, Wis., this 22nd day of August, 1975

Signature Philip T. Hansen Title Registered Land Surveyor Registration No. S-498  
(County Surveyor, Registered Land Surveyor, or other duly authorized official)

Office of Register of Deeds, County of Oneida 14th day of October 1975  
at 2:00 o'clock P. M. hereby certify that the within instrument was filed in this office for record on the

Doris Lange Tucker  
(Register of Deeds)

By: \_\_\_\_\_ Deputy

3610120030