

CERTIFIED LAND CORNER RESTORATION



Index No. **G-25**

State of Wisconsin }  
County of Oneida } ss.

I Phillip T. Hansen, do hereby certify that on the 6th day of January, 1977, I found evidence of the Quarter corner of Section 7 and 12 Township 36, North, Range 10 & 11 East, Fourth Principal Meridian, as described hereon; and that from this evidence I established a new monument and accessories as described hereon to perpetuate the original location of this corner.

Resident witnesses:

- Glen Barker
- Jim Claffin
- Herb Wagoner

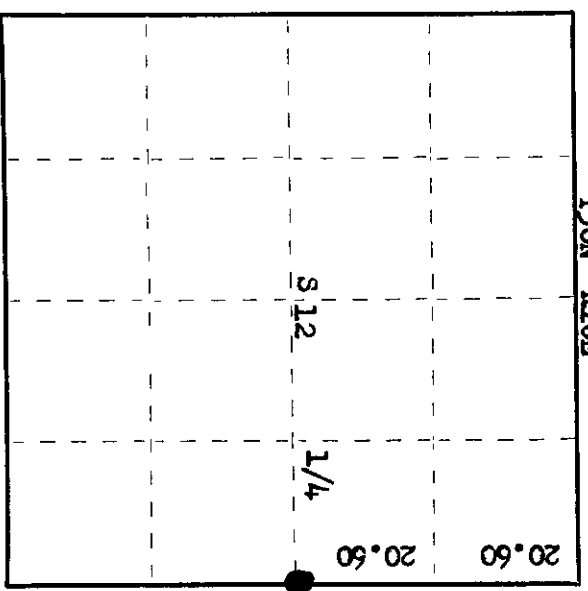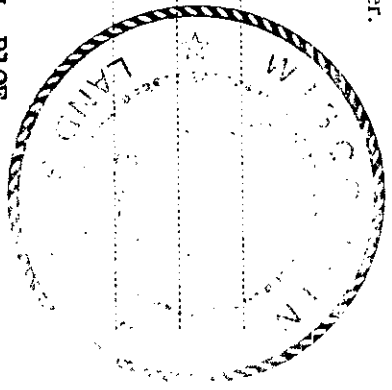

○ = Corner monument restored.

History of original corner establishment: Original Corner established by Hiram C. Fellows, Deputy Surveyor, in 1859, from which Tamarack 10" S 67° E 6 links and Pine 10" S 36° W 8 links. Corner recovered by D.H. Vaughan, County Surveyor, in 1905, who claimed he had found the original BTs.

H.C. Lawrence, Registered Land Surveyor, re-established this corner in 1951. He was unable to find any old evidence of previous establishment. He had recovered Vaughan's N 1/16 Corner, extended his random line, doubling his distance from Section Corner to N 1/16, 20.60 chains to 41.20 to set his new 1/4 corner. Set new post and marked NBTs Spruce Pine 12" S 75° E 30 links, Spruce Pine 10" S 76° W 34 1/2 links.

Description of corner evidence found:  
Recovered H.C. Lawrence's 5" pine post, squared and scribed 1/4, down and rotted.  
Recovered OBT - Spruce Pine 12" S 75° E 30 links, now a 5' stub, scribed 1/4 S7 NBT.  
Spruce Pine 10" S 76° W 34.5 links, now a decayed stump.

Description of monument and accessories I established to perpetuate the original location of this corner.

Replaced point of pine post with 2 1/2" Bernitsen A-1 Federal Monument, aluminum with magnet in cap and base. Cap stamped:  
NBTs - Black Spruce 8" N 56° E 1.27 chains, scribed 1/4 BT.      T36N      R  
Black Spruce 5" N 72° W 1.194 chains, scribed 1/4 BT.      1/4      S12      S7      R  
Jack Pine 6" S 33° W 1.683 chains, scribed 1/4 BT.      E      10      S7      11  
Monument projects 30" above ground.      S498-1977      E

Dated at Rhinelander, Wis., this 20th day of January, 1977.

Signature Phillip T. Hansen Title Registered Land Surveyor Registration No. S-498  
(County Surveyor, Registered Land Surveyor, or other duly authorized official)

Office of Register of Deeds, County of Oneida      I hereby certify that the within instrument was filed in this office for record on the 5th day of May, 1977 at 2:00 o'clock P. M.

Tonia Savage Fisher  
(Register of Deeds)

By \_\_\_\_\_ Deputy

3610122000