

CERTIFIED LAND CORNER RESTORATION

Index No. **N-25**

State of Wisconsin

County of Oneida } ss.

I Philip T. Hansen, do hereby



certify that on the 21st day of July, 1975, I found

evidence of the Section Corner Sections 13-24-18-19

corner of 36 Township, North, Range 10 and 11 East, Fourth Principal Meridian,

as described hereon; and that from this evidence I established a new monument and accessories as described hereon to perpetuate the original location of this corner.

Resident witnesses:

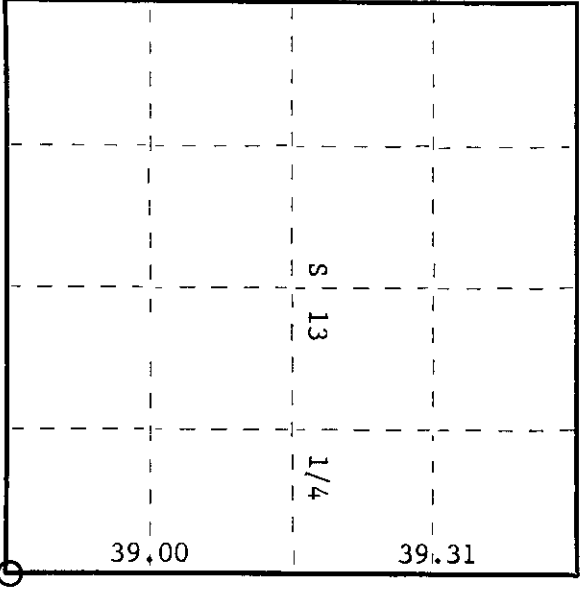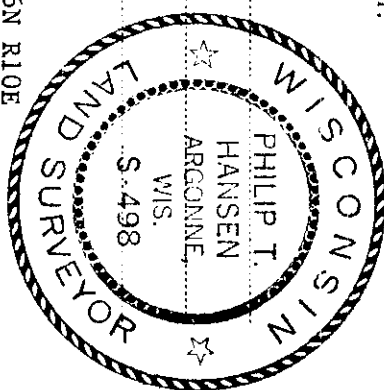

○ = Corner monument restored.

History of original corner establishment:

Original corner established by Hiram C. Fellows, Government Deputy Surveyor, in 1859, from which white pine 8" bears S57°W, 8 links; spruce 8" bears N50°W, 21 links; tamarack 14" bears N89°E, 17 links; and tamarack 14" bears S55°E, 22 links.

Corner recovered by D.H. Vaughan, County Surveyor, in 1900-11. Made NBT's - white pine 20" N23½°E 58 links and white pine 14" S37°E 21 links.

Corner recovered by H.C. Lawrence, Registered Land Surveyor, in 1946. Recovered stumps of Vaughan's BT's intact and was able to set new post, 4" cedar, in hole of old post.

Description of corner evidence found:  
 Recovered 4" cedar post, squared and scribed S13, S24; S19, S18 in fair condition. Also recovered 2-1/2" iron pipe with brass cap unstamped.

Recovered OBT's - White pine 20" - distance and bearing to iron pipe checks.  
 White pine 14" - now badly decayed.

Description of monument and accessories I established to perpetuate the original location of this corner. As 2-1/2" iron pipe was in excellent condition and in proper place, stamped it.

NBT's - W. birch 6" N13°E 46 links scribed SC BT. S498  
 W. birch 6" N51°W 53.6 links " " T36N  
 W. birch 5" S14°N 43.1 links " " "

Painted iron pipe, post, and BT's blue.

R	S13	S18	R
10			11
E	S24	S19	E

CPI-1975

Dated at Rhinelander, Wis., this 30th day of July, 1975.

Signature: *Philip T. Hansen* Title: Registered Land Surveyor Registration No. S-498  
 (County Surveyor, Registered Land Surveyor, or other duly authorized official)

Office of Register of Deeds, County of Oneida  
 Instrument was filed in this office for record on the 1st day of October, 1975  
 at 3:00 o'clock P.M.

*Doree Verage Knicker*  
 (Register of Deeds)

By: Deputy

3610130000