

CERTIFIED LAND CORNER RESTORATION

Index No. **N-23**



State of Wisconsin

County of Oneida } ss.

I Philip T. Hansen do hereby certify that on the 21st day of July, 1975, I found evidence of the Quarter corner of Section 13 and 24 Township 36 North, Range 10 East, Fourth Principal Meridian,

as described hereon; and that from this evidence I established a new monument and accessories as described hereon to perpetuate the original location of this corner.

Resident witnesses:

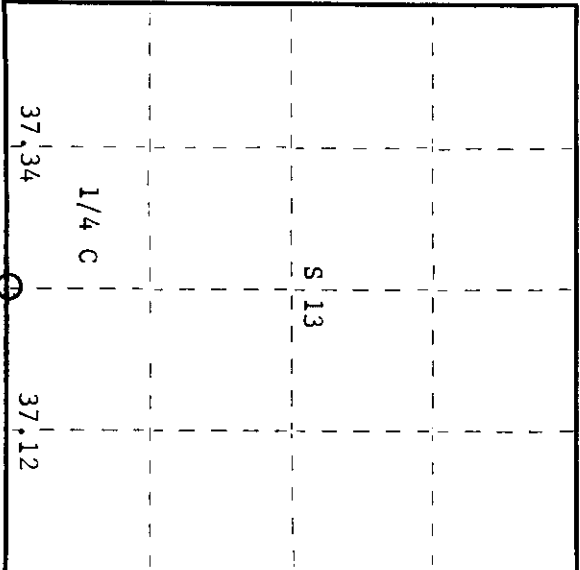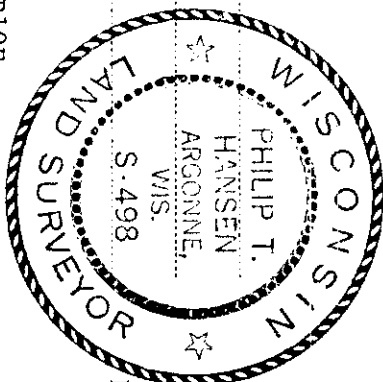

○ = Corner monument restored.

History of original corner establishment:

Original corner established by Wm. E. Dougherty, Government Deputy Surveyor, in 1859, from which hemlock 12" bears N46°E 14 links and birch 8" bears S52°W 18 links. Corner recovered by D.H. Vaughan in 1900. Established NBT's - spruce 8" bears S74½°W 30 links and tamarack 10" bears N3°E 39 links. Corner recovered by H.C. Lawrence, Registered Land Surveyor, in 1947. Recovered Vaughan's spruce 8", now down and rotten, and tamarack 10" N3°E 39 links, now a stump. Found remains of Vaughan's old stake and found old pint in the ground. Set new 4" cedar post in old post hole and marked NBT's - maple 10" S5 E 49 links and cedar 10" N58°E 115 links.

Description of corner evidence found:

Recovered 4" cedar post, squared and scribed 1/4 S S13, 1/4 S S24 in poor condition.

Recovered 0BT's - Tamarack 10" N3°E 39 links - now decayed stub.

Maple 10" S5°E 49 links - now cut-off stump.

Cedar 10" (11") N58°E (N60°E) 15 links - scribed NBT.

Description of monument and accessories I established to perpetuate the original location of this corner.

Replaced 4" cedar post with 2-1/2" iron pipe with brass cap stamped -

NBT - R. maple 5" S38°W 48.3 links - scribed 1/4 BT.

R. maple 6" N72°E 60.8 links - scribed 1/4 BT.

S498

T36N R10E

1/4 C S 13 S 24

CPI-1975

Dated at Rhinelander, Wis., this 30th day of July, 1975.

Signature *Philip T. Hansen* Title Registered Land Surveyor Registration No. S-498
(County Surveyor, Registered Land Surveyor, or other duly authorized official)

Office of Register of Deeds, County of Oneida
Instrument was filed in this office for record on the 1st day of October, 1975
at 3:00 o'clock P.M.

Donna W. Lange Kuehn
Register of Deeds

By _____ Deputy

3610130020