


CERTIFIED LAND CORNER RESTORATION

Index No. M-25


State of Wisconsin

County of Oneida } ss.

I Philip T. Hansen, do hereby certify that on the 18th day of July, 1975, I found evidence of the S-1/16 corner of Sections 13 and 18 Township 36 North, Range 10 and 11 East, Fourth Principal Meridian, as described hereon; and that from this evidence I established a new monument and accessories as described hereon to perpetuate the original location of this corner.

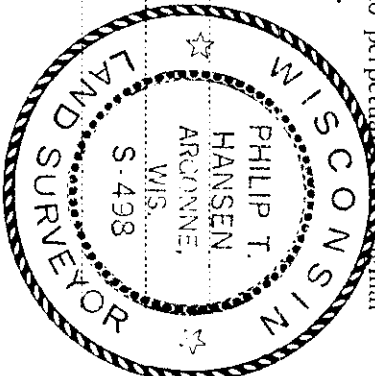

Resident witnesses:

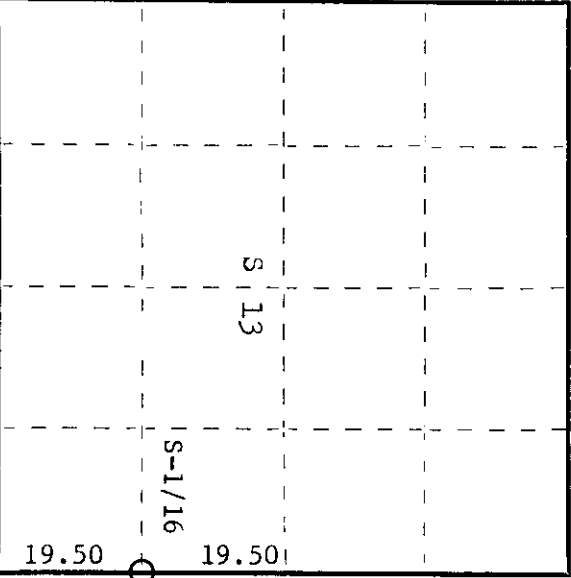

History of original corner establishment:

Corner established by H.C. Lawrence, Registered Land Surveyor, in 1947. From 1/4 corner between Sec. 13 and Sec. 18, restored from D.H. Vaughan's records and recovered BT's he ran south (3° var.) a distance of 39.00 chains to a point 1.88 chains west of section corner. Corrected bearing of line S59°45'E. Set the S-1/16 corner at 19.50 chains equidistant 94 links east. As this fell in CPI's road, he set a witness corner 10 links east from which white birch 8" bears N19°E 30 links and white birch 12" bears S80-1/2°W 102 links.

Description of corner evidence found:

Recovered 6" cedar post, squared and scribed S-1/16 S18, T36N R11E; S-1/16 S13, T36N R10E in poor condition. This is a witness post to true corner 10 links west.

Did not recover any of OBT's.

Description of monument and accessories I established to perpetuate the original location of this corner:

As witness post was 10 links east of true corner and this was on the east edge of the road, a new 1-1/2" O.D. iron pipe with 2" brass cap was set 30 links east of the true corner. A 1-1/2" O.D. x 18" iron pipe was driven in the road, flush with the ground for the true corner.

NBT's - White birch 7" S4°E 44.8 links - scribed 1/16 BT. Red maple 7" S83°E 49.2 links - scribed 1/16 BT.

Bearings and distances measured from the true corner. Consolidated's road crosses the range line at a point 19.77 chains north of section corner and 19.23 chains south of quarter corner.

Dated at Rhinelander, Wis., this 30th day of July, 1975.

Signature: [Signature] Title: Registered Land Surveyor To distribution No. S-498 (County Surveyor, Registered Land Surveyor, or other duly authorized official)

Office of Register of Deeds, County of Oneida. Instrument was filed in this office for record on the 1st day of October, 1975 at 3:00 o'clock P.M.

[Signature] (Register of Deeds)

By: [Signature] Deputy

361013100