

CERTIFIED LAND CORNER RESTORATION


INDEX No. L-25

State of Wisconsin


County of Oneida } ss.

I Phillip T. Hansen, do hereby certify that on the 18th day of July, 19 75, I found evidence of the Quarter corner of Sections 13 and 18 Township 36, North, Range 10 and 11 East, Fourth Principal Meridian,

as described hereon; and that from this evidence I established a new monument and accessories as described hereon to perpetuate the original location of this corner.

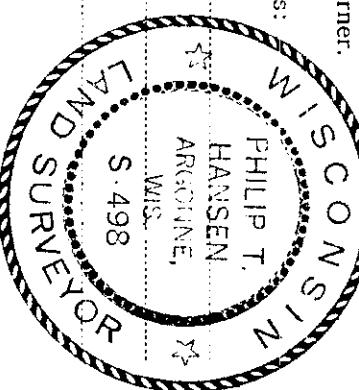

Resident witnesses:

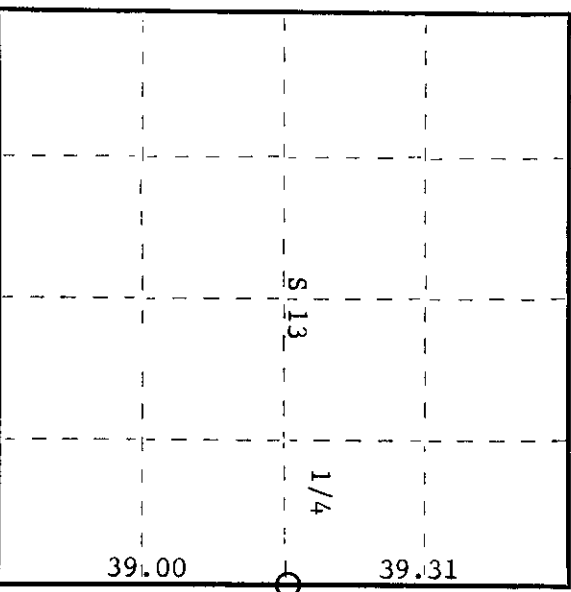

History of original corner establishment:  
Original corner established by Hiram C. Fellows, Government Deputy Surveyor, in 1859, from which tamarack 12" bears S48°W, 13 links, and tamarack 20" bears N40°E, 20 links.

Corner restored by H.C. Lawrence, Registered Land Surveyor, in 1947. Recovered original tamarack BT S48°E, 13 links, now a 6' stub, and tamarack 20" N40°E, 20 links, now a stump. He set a new 6" cedar post from these BT's and made NBT's - white birch 8" N190°E, 30 links, and white birch 12", S80-1/2°W, 102 links.

Description of corner evidence found:

Recovered 6" cedar post, squared and scribed 18 R11E; 1/4 S T36N, S13 R10E 1/4 S in fair condition.

Recovered OBT - White birch 8" N19°E 30 links - now a 3' stub scribed 1/4 S 18.

White birch 12" S80 1/2°W 102 links - now rotted and fallen down scribed 1/4 S 13 NBT.

Description of monument and accessories I established to perpetuate the original location of this corner.

Replaced 6" cedar post with 2-1/2" iron pipe with brass cap stamped -

NBT's - Black spruce 9" S18°E 25.4 links scribed 1/4 BT.

S498  
T36N

Red maple 5" N8°E 52.5 links scribed 1/4 BT.

R 10 S13 S18 11  
E 1/4 E  
CPI-1975

Dated at Rhineland, Wis., this 30th day of July, 19 75

Signature Phillip T. Hansen Title Registered Land Surveyor Registration No. S-498  
(County Surveyor, Registered Land Surveyor, or other duly authorized official)

Office of Register of Deeds, County of Oneida 1st day of October 19 75  
at 3:00 o'clock P. M. I hereby certify that the within instrument was filed in this office for record on the

Karen Savage Kiehn  
(Register of Deeds)

By \_\_\_\_\_ Deputy

361013200