

CERTIFIED LAND CORNER RESTORATION

Index No. **L-23**

State of Wisconsin

County of Oneida } ss.



I Phillip T. Hansen, do hereby

certify that on the 25th day of July, 1975, I found evidence of the C-1/4 corner of Section 13

Township 36 North, Range 10 East, Fourth Principal Meridian,

as described hereon; and that from this evidence I established a new monument and accessories as described hereon to perpetuate the original location of this corner.

Resident witnesses:

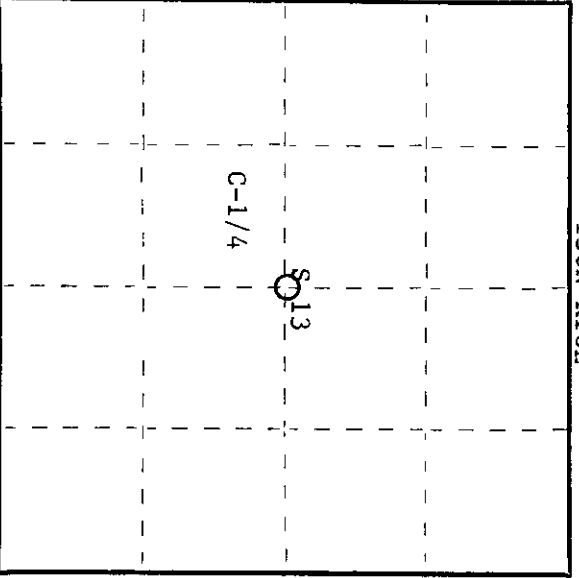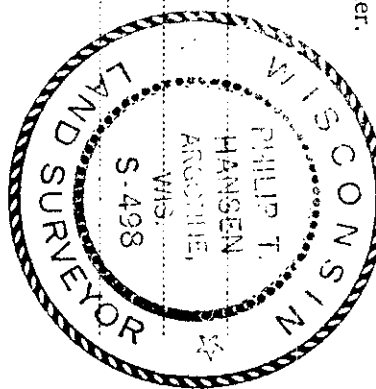

○ = Corner monument restored.

History of original corner establishment:

Original corner established by D.H. Vaughan, County Surveyor in 1900-11, from which hemlock 10" bears N54°E 39 links and maple 12" bears S46°E 28 links.

Corner recovered by H.C. Lawrence, Registered Land Surveyor in 1947. Set new post and made NBT's - sugar 10", S14°E, 33 links and sugar 12" bears N63°W 39 links.

Description of corner evidence found:

Recovered old 3" cedar post squared and scribed on one side C-1/4 S13 in very poor condition.

Recovered OBT - Maple 12" S46°E 28 links scribed C-1/4 S13 BT, now a stub.

Sugar 10" (12") S14°E 33 links scribed C-1/4, bottom scribe grown over.

Hemlock 10" N54°E 39 links, now a decayed stub.

Sugar 12" N63°W 39 links, blown down and rotted.

No trace of Lawrence's corner post.

Description of monument and accessories I established to perpetuate the original location of this corner.

Replaced old wooden post with 2-1/2" iron pipe with brass cap stamped -

NBT - Sugar 6" N20°E 18.1 links scribed 1/4 BT. S498

Sugar 10" N20°W 45.4 links scribed 1/4 BT. T36N R10E

C-1/4 S13
CPI-1975

Dated at Rhinelander, Wis., this 31st day of July, 1975.

Signature *Phillip T. Hansen* Title Registered Land Surveyor Registration No. S-498
(County Surveyor, Registered Land Surveyor, or other duly authorized official)

Office of Register of Deeds, County of Oneida
Instrument was filed in this office for record on the 1st day of October, 1975
at 3:00 o'clock P.M.

Debra Verage Kuehn
(Register of Deeds)

By: Deputy

3610132020