

CERTIFIED LAND CORNER RESTORATION



Index No. **L-222**

State of Wisconsin

County of Oneida } ss.

I Philip T. Hansen, do hereby certify that on the 1st day of July, 1975, I found evidence of the WC-1/16 corner of the Section 13 Township 36 North, Range 10 East, Fourth Principal Meridian, as described hereon; and that from this evidence I established a new monument and accessories as described hereon to perpetuate the original location of this corner.

Resident witnesses:
 Glen Parker
 Jim Claflin

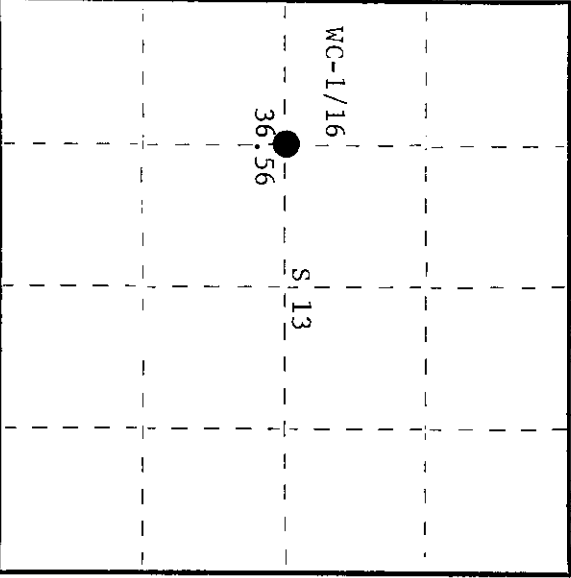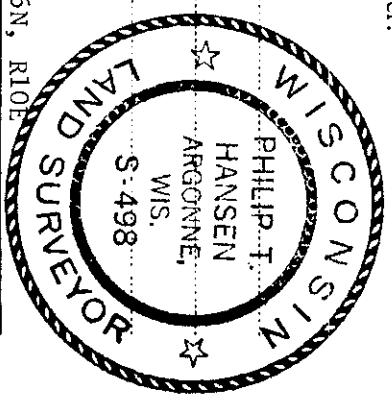

○ = Corner monument restored.

History of original corner establishment:
 Original corner established by D.H. Vaughan, County Surveyor, in 1900-1911 from which pine stump 24" bears N72°E, 17 links and W. pine stump 20" bears S81°W, 11 links.
 Corner recovered by H.C. Lawrence, Registered Land Surveyor, in 1947. States he recovered Vaughan's W. pine stumps okay and set new post and marked NBT's - viz. hemlock 16", S46°E, 39 links and hemlock 14", S89°W, 34 links.

Description of corner evidence found:
 Recovered Lawrence's 4" cedar post, squared and scribed WC-1/16 S13, WC-1/16 S13, in poor condition.
 Recovered - W. pine stump 24" N72°E 17 links - now badly decayed
 W. pine stump 20" S81°W 11 links - now decayed
 Hemlock 16" (18") S46°E 39 links - scribed WC-1/16 NBT, good condition
 Hemlock 14" (16") S89°W 34 links - scribed WC-1/16 NBT, good condition

Description of monument and accessories I established to perpetuate the original location of this corner.
 Replaced 4" cedar stake with 1 1/2" OD iron pipe with 2" brass cap stamped - S498
 T36N, R10E
 No additional accessories established.

WC-1/16 S13

GPI-1975

Dated at Rhineland, Wis., this 22nd day of August, 1975

Signature *Philip T. Hansen* Title Registered Land Surveyor Registration No. S-498
 (County Surveyor, Registered Land Surveyor, or other duly authorized official)

Office of Register of Deeds, County of Oneida
 Instrument was filed in this office for record on the 14th day of October, 1975 at 2:00 o'clock P.M.

Donis Verage Tynker
 (Register of Deeds)

By: Deputy

3610132030