

CERTIFIED LAND CORNER RESTORATION

Index No. N-21

State of Wisconsin

County of Oneida } ss.

I Phillip T. Hansen, do hereby



certify that on the 25th day of July, 1975, I found

evidence of the Section corner of S13, S14, S23, S24

Township 36, North, Range 10 East, Fourth Principal Meridian,

as described hereon; and that from this evidence I established a new monument and accessories as described hereon to perpetuate the original location of this corner.

Resident witnesses:

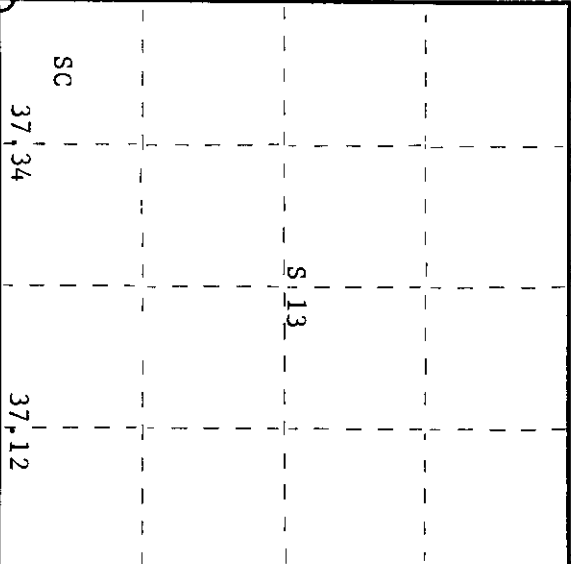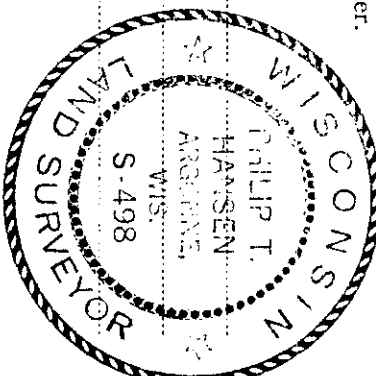

○ = Corner monument restored.

History of original corner establishment:

Original corner established by Wm. E. Dougherty, Government Deputy Surveyor, in 1859 from which birch 8" bears N70°W 27 links, aspen 8" bears S61°E 34 links.

Corner recovered by D.H. Vaughan, County Surveyor 1900-11. Set new post from which cedar 12" bears N71°E 20 links and cedar 10" bears S46°W 22 links.

Description of corner evidence found:

Corner recovered - old squared cedar post badly decayed with 2-1/2" iron pipe w/brass cap beside it stamped S13, S14, S23, S24. A Wisconsin Conservation Location tag on a nearby cedar dated 2/28/42.

Recovered Vaughan's cedar 10" S46°W 22 links uprooted and decayed.

cedar 12" (16") N71°E 20 links scribed T36N R10E S13 BT.

This tree is uprooted and leaning badly.

cedar 11" N40°W 12.4 links scribed S14 BT.

Iron pipe believed to have been set by WCD. Names of C. Freund & F. Meyers written on location poster and Vaughan's BT.

Description of monument and accessories I established to perpetuate the original location of this corner. We extracted the iron pipe and old post from the muck and reset it deeper in old post hole. Restamped brass cap.

NBT - Cedar 7" N58°E 29.2 links scribed SC BT
Cedar 8" S68°W 41.4 links scribed SC BT

S498
T36N R10E
S14 | S13
S23 | S24
CPI-1975

Dated at Rhineland, Wis., this 31st day of July, 1975.

Signature Phillip T. Hansen Title Registered Land Surveyor Registration No. S-498
(County Surveyor, Registered Land Surveyor, or other duly authorized official)

Office of Register of Deeds, County of Oneida
Instrument was filed in this office for record on the 1st day of October, 1975
at 3:00 o'clock P. M.

Doris M. Kuehn
(Register of Deeds)

By: _____ Deputy

3610140000