

CERTIFIED LAND CORNER RESTORATION



Index No. **N-20**

History of original corner establishment:  
 Corner established by D.H. Vaughan, County Surveyor, in 1900. Set post from which  
 Lynn 8" bears S39°E, 19 links.  
 Corner recovered by H.C. Lawrence, Registered Land Surveyor. Set new post, 4" cedar,  
 in old posthole.

State of Wisconsin }  
 County of Oneida } ss.

I Philip T. Hansen, do hereby  
 certify that on the 24th day  
 of July 19 75, I found  
 evidence of the E-1/16  
 corner of Sections 14 and 23  
 Township 36 North, Range  
 10 East, Fourth Principal Meridian,  
 as described hereon; and that from this evidence  
 I established a new monument and accessories  
 as described hereon to perpetuate the original  
 location of this corner.

Resident witnesses:

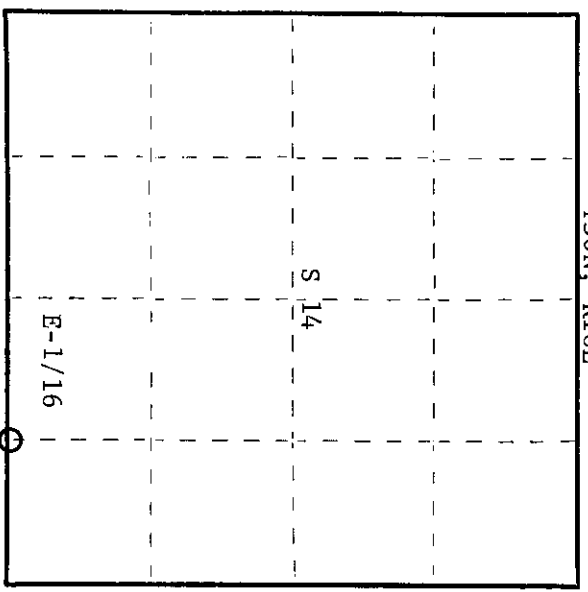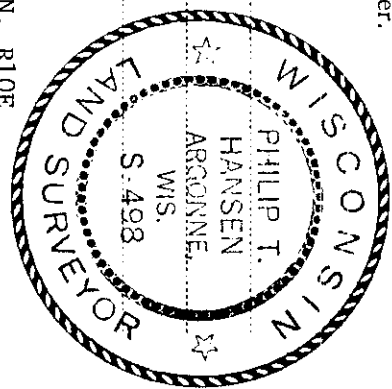

○ = Corner monument restored.

Description of corner evidence found:  
 Recovered 4" cedar post, squared and scribed E-1/16 S14, E-1/16 S23, in poor condition.  
 Recovered OBT's sugar maple 11", N31°W, 35.7 links, scribing partly visible, and yellow  
 birch 10", S58°E, 34.3 links, scribed BT.  
 No notes on file on the above BT's; scribing was Lawrence's.  
 Lynn 16", S39°E, 19 links (Vaughan's). No evidence of this BT.

Description of monument and accessories I established to perpetuate the original location of this corner:  
 Replaced wooden post with 1½" OD iron pipe with brass cap stamped -

- |                         |       |            |                 |            |
|-------------------------|-------|------------|-----------------|------------|
| NBT's - Sugar maple 10" | N5°W  | 32.0 links | scribed 1/16 BT | S498       |
| Sugar maple 8"          | S62°W | 41.8 links | scribed 1/16 BT | T36N, R10E |
|                         |       |            |                 | S114       |
|                         |       |            |                 | S123       |

CPI-1975

Dated at Rhinelander, Wis., this 4th day of August, 19 75.

Signature *Philip T. Hansen* Title Registered Land Surveyor Registration No. S-498  
 (County Surveyor, Registered Land Surveyor, or other duly authorized official)

Office of Registrar of Deeds, County of Oneida, at 302 o'clock P.M. 1st day of October 1975  
 instrument was filed in this office for record on the

*Dorcas Verage Kuehn*  
 (Registrar of Deeds)

By Deputy

3610140010