



CERTIFIED LAND CORNER RESTORATION

Index No. N-11

State of Wisconsin }
 County of Oneida } ss.

I Phillip T. Hansen, do hereby certify that on the 20th day of June, 1979, I found evidence of the Quarter corner of Sections 16 and 21 Township 36, North, Range 10 East, Fourth Principal Meridian, as described hereon; and that from this evidence I established a new monument and accessories as described hereon to perpetuate the original location of this corner.

Resident witnesses:
Jim Clafflin
Herb Wagoner
Isabel McKay

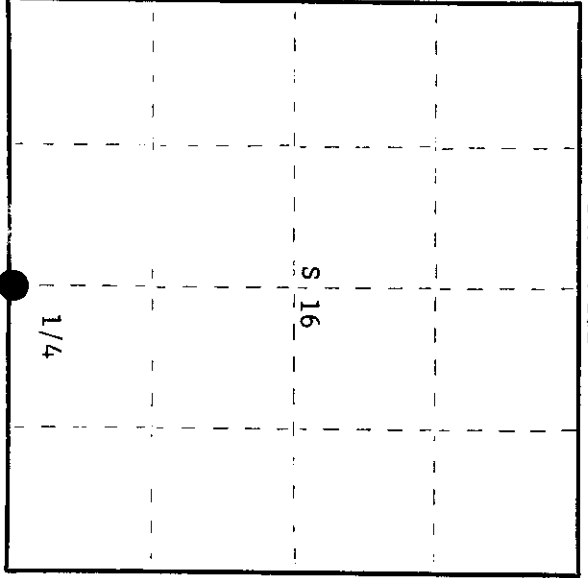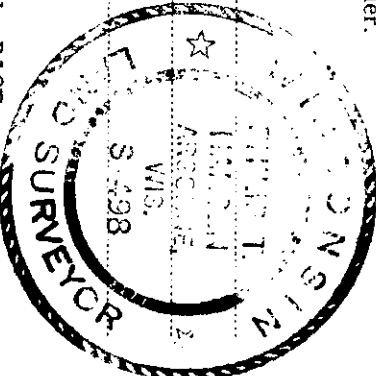

○ = Corner monument restored.

History of original corner establishment:

Original corner established by Wm. E. Dougherty, Deputy Surveyor, in 1863, from which pine 10" bears N7°W 48 links and pine 8" bears S41°E 37 links. H.C. Lawrence, Registered Land Surveyor, visited this corner in 1948 and recovered both original BT's. The 8" BT was a high stub, fire scarred, but marks visible. The 10" BT was broken off and fire scarred, chopped out overgrowth which revealed 1/4S mark. Set new post and marked NBT's - B.Pine 5" S7°E 11-1/2 links and B.Pine 6" N7°E 14 links. He revisited corner in 1954. The 5" BT S7°E had been cut but others remained.

Description of corner evidence found:

Recovered H.C. Lawrence's 4" squared tamarack post, scribed 1/4 S S16, 1/4 S S21 in poor condition.
 Recovered original BT - Pine 10" N7°W 48 links, snag standing, scribing visible.
 B.Pine 8" S41°E 51.0 links, stump remains, blazes apparent.
 Sp. Pine 5" S7°E 11.5 links, stump only, scribing visible.
 Sp. Pine 6" N7°E 14 links, now a stump, scribing visible.

Description of monument and accessories I established to perpetuate the original location of this corner.

Replaced H.C. Lawrence's post with 2-1/2" Berntsen A-1 Federal Monument, stamped: Monument projects 12".
 Marked NBT's - J.Pine 6" S52°E 16.2 links
 J.Pine 6" S10°E 6.4 links
 W.Birch 5" S59°W 23.2 links
 J.Pine 7" N24°E 22.8 links
 all BT's scribed 1/4 BT.

S498-1979
 T36N R10E
 1/4 S 16
 S 16
 1/4 S 21

Dated at Rhinelander, Wis., this 28th day of January, 1980

Signature: Phillip T. Hansen Title: Registered Land Surveyor Registration No. S-498
 County Surveyor, Registered Land Surveyor, or other duly authorized official)
 Office of Register of Deeds, County of Oneida
 at 9:10 o'clock a M. 10th day of March, 1980

I hereby certify that the within instrument was filed in this office for record on the 10th day of March, 1980
 By: Doris Savage Funder Deputy
 (Register of Deeds)

3610160020

CERTIFIED LAND CORNER RESTORATION

Index No. N-11



State of Wisconsin

County of Oneida } ss.

I Philip T. Hansen, do hereby certify that on the 20th day of June, 1979, I found evidence of the Quarter corner of Sections 16 and 21 Township 36, North, Range 10, East, Fourth Principal Meridian, as described hereon; and that from this evidence I established a new monument and accessories as described hereon to perpetuate the original location of this corner.

History of original corner establishment:
Original corner established by Wm. E. Dougherty, Deputy Surveyor, in 1863, from which black pine 10" bears N7°W 48 links and black pine 8" bears S41°E 51 links.
Corner recovered by D.H. Vaughan, County Surveyor, in 1912. Recovered the original BT's. Set a new post.
Corner recovered by H.C. Lawrence, Registered Land Surveyor, in 1948. Recovered stumps of original BT's. Set a new cedar post.

Resident witnesses:
Jim Clafflin
Herb Wagoner
L. McKay

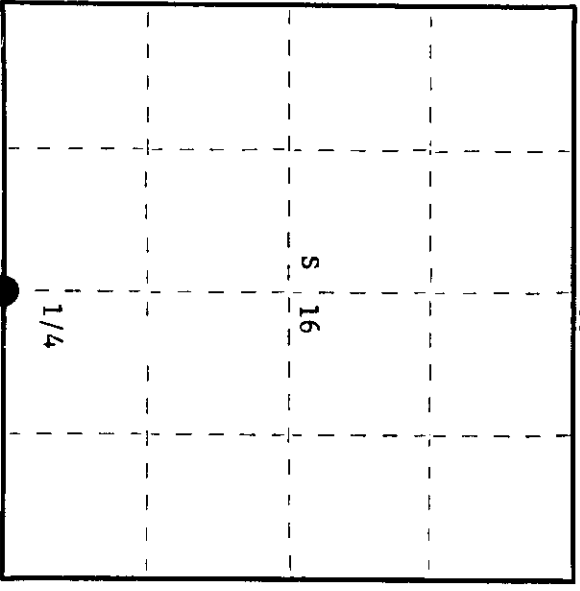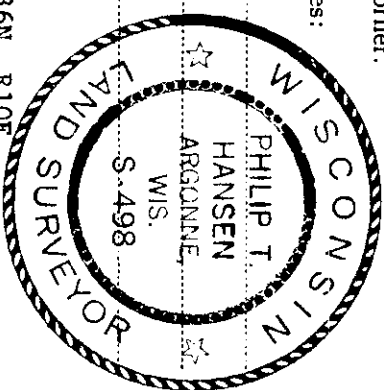

○ = Corner monument restored.

Description of corner evidence found:
Recovered H.C. Lawrence's 4" squared cedar post, in poor condition, scribed 1/4S S16, 1/4S S21.
Recovered original BT's - Black Pine 10" N7°W 48.0 links, now a snag still standing.
Black Pine 8" S41°E 51.0 links, now a stump, scribbling visible.
Spruce pine 5" S7°E 11.5 links, now a stump, scribbling visible.
Spruce pine 6" N7°E 14 links, now a stump, scribbling visible.

Description of monument and accessories I established to perpetuate the original location of this corner.
Replaced H.C. Lawrence's wood post with 2 1/2" Berntsen A-1 Federal Monument (O.C.) - stamped: Monument projects 12" above ground.

- Marked NBT's -
- Jack Pine 6" S52°E 16.2 links S498 - 1979
 - Jack Pine 6" S10°E 6.4 links T36N R10E
 - White Birch 5" S69°W 23.2 links
 - Jack Pine 7" N24°E 22.8 links 1/4 S+16
- all scribed 1/4 BT

Dated at Rhineland, Wis., this 27th day of July, 1979

Signature Philip T. Hansen, Title Registered Land Surveyor Registration No. S-498
(County Surveyor, Registered Land Surveyor, or other duly authorized official)

Office of Register of Deeds, County of Oneida, I hereby certify that the within instrument was filed in this office for record on the 7th day of August, 1979 at 10 o'clock A. M.

Thomas W. Keenan
(Register of Deeds)

By: _____ Deputy

3610160020