

CERTIFIED LAND CORNER RESTORATION


Index No. **A-9**

State of Wisconsin }
 County of Oneida } ss.

I Phillp T. Hansen, do hereby certify that on the 2nd day of December 19 75, I found evidence of the Section corner of S17, 16, 21, 20 Township 36, North, Range 10 East, Fourth Principal Meridian, as described hereon; and that from this evidence I established a new monument and accessories as described hereon to perpetuate the original location of this corner.

Resident witnesses:

Glen Barker
Jim Clafin

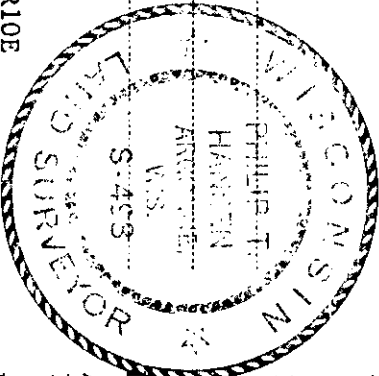

History of original corner establishment: Original corner established by William F. Dougherty, Deputy Surveyor, in 1863 from which white pine 16" bears N79°E, 23 links and yellow pine 16" bears S61°W, 81 links. Corner restored in 1938 by unknown source. Corner recovered and restored in 1948 by H.C. Lawrence, Registered Land Surveyor. Found a white conservation post with location poster attached. Also, a white pine 16" with old scar facing towards post. He chopped into it and found scribing S20 BT, which according to growth rings was made in 1938.

Set new posts and measured to OBT - W. pine 16" S70°W 164 links
 Jack pine 7" N79°W 26 links


Description of corner evidence found:
 Recovered 2" iron pipe with brass cap stamped -
 Pipe projects 18" above ground.
 Also found Lawrence's 5" tamarack post, squared and scribed, lying beside it. Measurements and bearings to BT's fit perfectly.

Recovered OBT's - W. pine 16" (24") S70°W 164 links scribed S20 BT.
 Jack pine 9" (12") N79°W 26 links scribing grown over.

T36N R10E	
17	16
20	21

Description of monument and accessories I established to perpetuate the original location of this corner.
 As iron pipe was in perfect condition it was left in place.
 Painted pipe and OBT's blue.

NBT - W. birch 10" S42°E 9.5 links scribed SC BT.

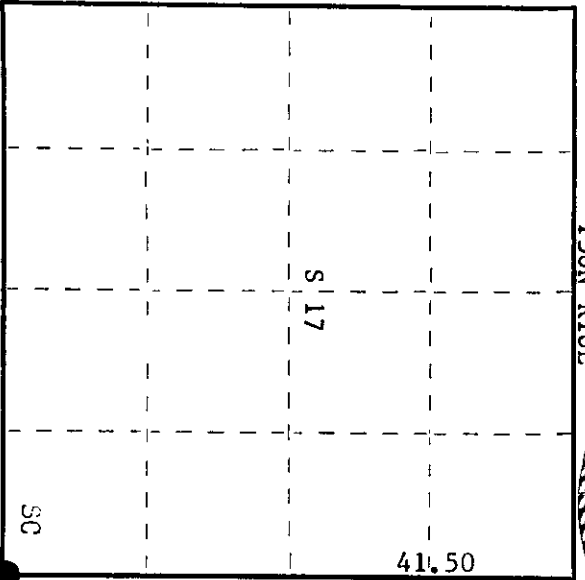

○ = Corner monument restored.

Dated at Rhineland, Wis., this 9th day of December, 19 75.

Signature Phillp T. Hansen Title Registered Land Surveyor Registration No. S-498
 (County Surveyor, Registered Land Surveyor, or other duly authorized official)

Office of Register of Deeds, County of Oneida, I hereby certify that the within instrument was filed in this office for record on the 4th day of June, 19 75 at 1:00 o'clock P. M.

James F. Hansen
 (Register of Deeds)

By _____ Deputy

361017000