

CERTIFIED LAND CORNER RESTORATION

Index No. **N-8**



State of Wisconsin }  
County of Oneida } ss.

I Phillip T. Hansen do hereby  
certify that on the 2nd day  
of December 19 75, I found  
evidence of the E-1/16  
corner of Section 17 and 20  
Township 36, North, Range  
10 East, Fourth Principal Meridian,

as described hereon; and that from this evidence  
I established a new monument and accessories  
as described hereon to perpetuate the original  
location of this corner.

Resident witnesses:

Glen Barker  
Jim Clafflin

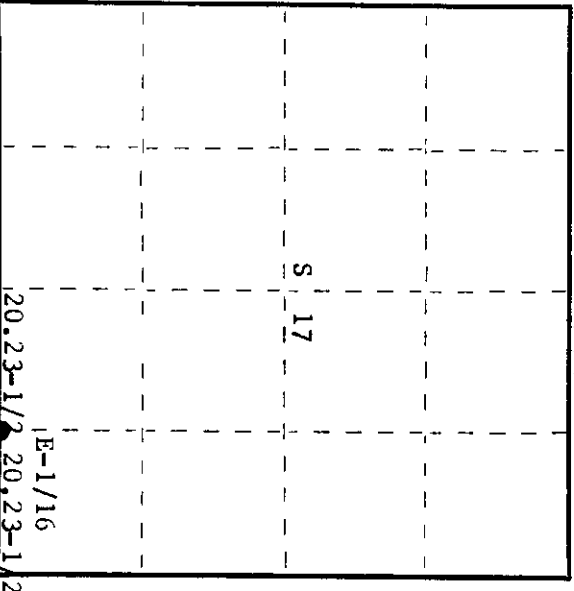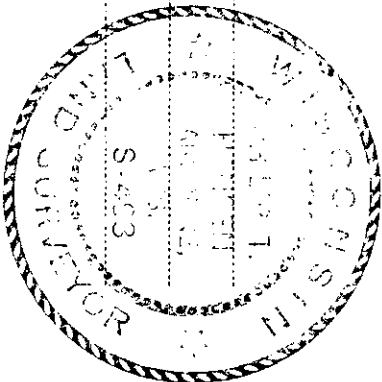

○ = Corner monument restored.

History of original corner establishment: Corner established by H.C. Lawrence, Registered Land Surveyor, in 1948. Corner set at 20.65 chains East of re-established quarter corner, equidistant between it and Northeast corner, in an open spruce and tamarack swamp.

Made NBT's - Tamarack 3" S10°E 40-1/2 links  
Spruce 3" N3°E 25-1/2 links

Corner recovered by N. Loftus, Registered Land Surveyor for St. Regis Paper Co. Traversed line from S-1/4 corner to SW corner. Reset E-1/16 at 21.23-1/2 chains S86°31'W of 1/4 corner. Set iron pipe with aluminum cap.

Description of corner evidence found: Recovered 2" iron pipe with aluminum cap stamped - Also, Lawrence's 3" tamarack post, squared and scribed E-1/16 S17, S20. Also, a 1" O.D. iron pipe. All three are within a .5 link radius.

No evidence of Lawrence's BT's.

E-1/16      S 17  
                  |  
                  S 20

Recovered BT - Jack pine 5" N58°E 39.6 links scribed E-1/16 BT  
Tamarack 6" S5°W 37.5 links scribed E-1/16 BT

Description of monument and accessories I established to perpetuate the original location of this corner.

As iron pipe was in very good condition, it was left in place. Added T36N, R10E to cap. Painted iron pipe, wood post, and BT's blue. No additional accessories established.

Dated at Rhineland, Wis., this 9th day of December, 1975.

Signature Phillip T. Hansen Title Registered Land Surveyor Registration No. S-498  
(County Surveyor, Registered Land Surveyor, or other duly authorized official)

Office of Register of Deeds, County of Oneida  
Instrument was filed in this office for record on the 4th day of January, 1976  
at 4:00 o'clock P. M.

Terrence Kirshen  
(Register of Deeds)

By: \_\_\_\_\_ Deputy

3610170010