

CERTIFIED LAND CORNER RESTORATION

Index No. **N-3**

State of Wisconsin

County of Oneida } ss.

I, Phillip T. Hansen, do hereby

certify that on the 31st day of December, 1976, I found

evidence of the Quarter corner of Section 18 & 19

Township 36, North, Range 10 East, Fourth Principal Meridian,



as described hereon; and that from this evidence I established a new monument and accessories as described hereon to perpetuate the original location of this corner.

Resident witnesses:

Glen Barker

Jim Clafin

Herb Wagoner

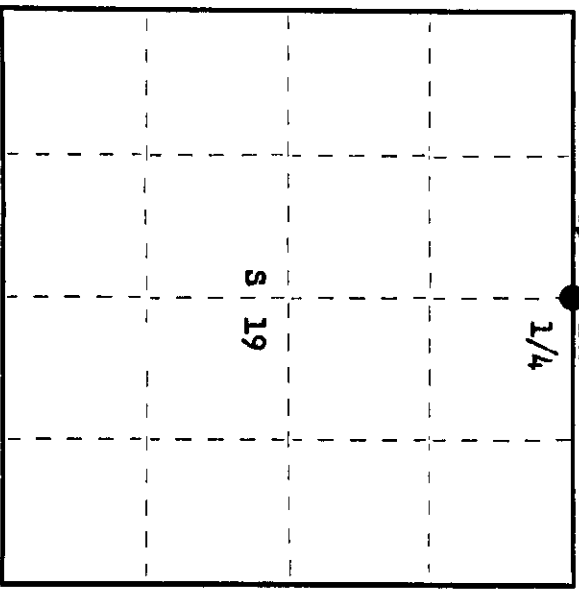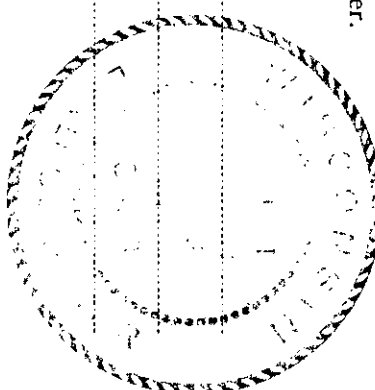

○ = Corner monument restored.

History of original corner establishment:

Original Corner established by Wm. E. Dougherty, Deputy Surveyor, in 1863, from which Tamarack 6" bears N 36° W 23.4 links and Tamarack 7" bears S 56° E 31.6 links.

Corner recovered by D.H. Vaughan, County Surveyor, in 1915. Set new post and marked NBTs - White Pine 12" N 27° E 31 links and White Pine 10" S 82½° E 33-3/4 links.

H.C. Lawrence, Registered Land Surveyor, recovered old iron pipe and Vaughan's post. Recovered stumps of Vaughan's BTs. Set new post and marked NBT - Tamarack 6" N 65° E 48½ links.

Description of corner evidence found:
 Recovered 2½" iron pipe with brass cap stamped:
 Origin of this monument unknown. A rock cairn had been placed around base of pipe.
 Recovered a piece of Vaughan's old post and Lawrence's post, scribed 1/4S S18, 1/4S S19 laying on rock cairn.
 Recovered OBTs - White Pine 12" N 27° E 3 links, now a decayed stump.
 Tamarack 6" N 65° E 48.5 links; however, it had been pushed out of place by bulldozer for highline clearing.

18
14
19

Description of monument and accessories I established to perpetuate the original location of this corner.

As the iron pipe was in very good condition, it was left in place. Monument projects 2½' above ground.

Corner sets 50 links west of west edge of highline R.O.W. and 2 chains south of B. NBTs - Jack Pine 12" S 80° W 85.7 links, scribed 1/4 BT.
 Jack Pine 6" S 2° E 63.4 links, scribed 1/4 BT.
 Oak 8" N 38° W 52.2 links, scribed 1/4 BT.

Dated at Rhineland, Wis., this 24th day of January, 1977

Signature Phillip T. Hansen Title Registered Land Surveyor Registration No. S-498
 (County Surveyor, Registered Land Surveyor, or other duly authorized official)

Office of Register of Deeds, County of Oneida
 instrument was filed in this office for record on the 24th day of February, 1977
 at 1:00 o'clock P. M.

Debra Wenge Kuehn
 (Register of Deeds)

By _____ Deputy

3610180026