

CERTIFIED LAND CORNER RESTORATION

Index No. P-5

State of Wisconsin



County of Oneida } ss.

I Phillip T. Hansen, do hereby certify that on the 9th day of February, 1979, I found evidence of the Quarter corner of Sections 19 & 20 Township 36, North, Range 10 East, Fourth Principal Meridian, as described hereon; and that from this evidence I established a new monument and accessories as described hereon to perpetuate the original location of this corner.

Resident witnesses:

Glen Barker

Herb Wagoner

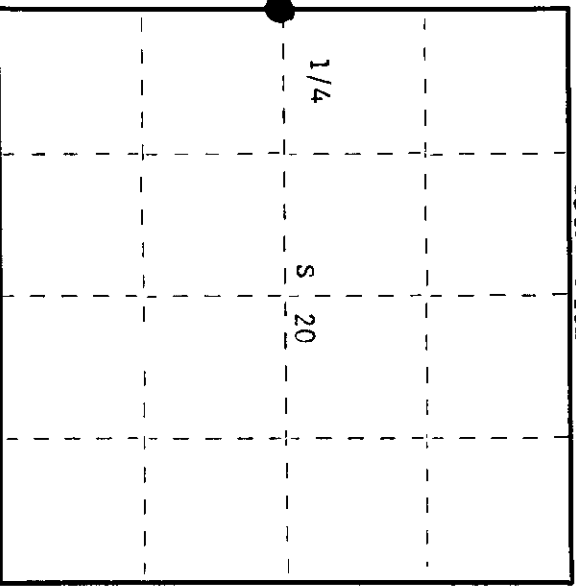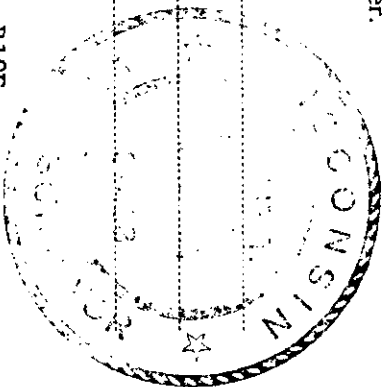

○ = Corner monument restored.

History of original corner establishment:

Original corner established by Wm. E. Dougherty, Government Deputy Surveyor, in 1863. White Pine 36" N65°E 78 links. Corner recovered by H.C. Lawrence, Registered Land Surveyor. Recovered old scribed 1/4 corner in line with old fence broken off and lying on ground. Dug out old point and set new tamarack post in place. Made NBT's - Spruce Pine 12" S84½°E 16 links Spruce Pine 6" S55°W 22 links Upturned roots of large white pine N81°W 29.5 links.

Description of corner evidence found:

Recovered H.C. Lawrence's 6" squared tamarack post lying down scribed 1/4S - S19 - 1/4S - S20. Also old cedar stake beside it. Recovered old post point. OBT's - Spruce Pine 12" S84½°E 16 links - now uprooted and down. Spruce Pine 6" S55°W 22 links - now a cut off stump. Upturned roots of large white pine N81°W 29.5 links (28.3 links)., scribed 1/4 BT - appears root system fell toward center.

Description of monument and accessories I established to perpetuate the original location of this corner.

Replaced old point with a 2½" Bernsten A-1 Federal Monument, projecting 12" above ground. Cap stamped:

Marked NBT's -  
 Black Spruce 7" N43°W 14 links - scribed 1/4 BT T36N R10E  
 Black Spruce 5" S1°W 43.5 links - scribed 1/4 BT 1/4 1979  
 Black Spruce 6" S16°W 106.9 links - scribed 1/4 BT  
 Jack Pine 5" S72°W 118 links - scribed 1/4 BT S498 - 1979

Dated at Rhineland, Wis., this 20th day of February, 1979

Signature: Phillip T. Hansen Title: Registered Land Surveyor Registration No. S-498  
 (County Surveyor, Registered Land Surveyor, or other duly authorized official)

Office of Register of Deeds, County of Oneida  
 Instrument was filed in this office for record on the 13th day of March, 1979  
 at 1:30 o'clock P. M.

Dona Waage Kuehn  
 (Register of Deeds)

By Dona Waage Kuehn Deputy

3610192000