

CERTIFIED LAND CORNER RESTORATION



Index No. P-3

State of Wisconsin

County of Oneida } ss.

I, Phillip T. Hansen, do hereby certify that on the 15th day of August, 1979, I ~~restored~~ established ~~restored~~ the C 1/4 corner of Section 19 Township 36, North, Range 10 East, Fourth Principal Meridian, as described hereon; and that from this evidence I established a new monument and accessories as described hereon to perpetuate the original location of this corner.

Resident witnesses:  
Glen Barker  
Jim Claflin  
Herb Wagoner

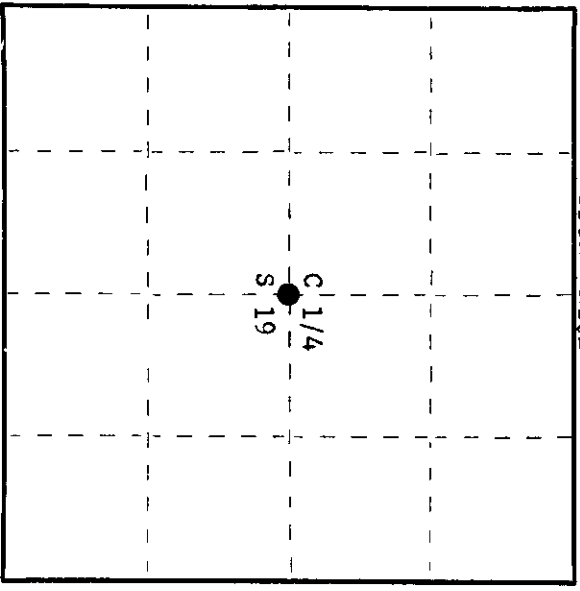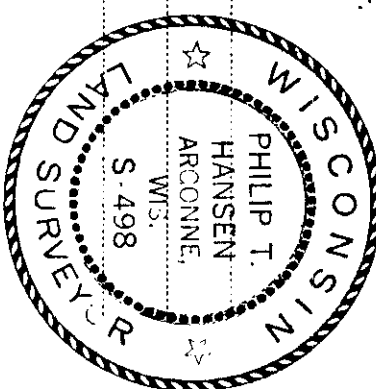

○ = Corner monument restored.

History of original corner establishment:

H.C. Lawrence, Registered Land Surveyor, checked on E-W fence line which was accepted as the E-W 1/4 line in 1949, but found this fence line to be erroneous. No effort was made by him to correct it.

Description of corner evidence found:

No evidence of any corner recovered. Corner established by traverse and computation. Ran traverse from N 1/4 corner to South 1/4 corner and from E 1/4 corner to W 1/4 corner. Computed position of corner sets S 2° 49' 20" W, 2743.726 feet from N 1/4 corner; S 79° 16' 55" W, 2570.280' from E 1/4; N2° 49' 20" E, 2649.305' from S 1/4; N79° 16' 55" E, 2608.261' from W 1/4.

Description of monument and accessories I established to perpetuate the original location of this corner.  
Set a 2-1/2" Bernitsen A-1 Federal Monument, projecting 18" - stamped:

- Marked NBT's -
- Jack Pine 10" S18° W 34.5 feet, stamped C 1/4 BT. T36N R10E
- Jack Pine N86° W 40.88' stamped C 1/4 BT. C 1/4 S 19
- White Pine 9" N8° W 68.49' stamped C 1/4 BT. S498 - 1979

Dated at Rhineland, Wis., this 20th day of August, 1979

Signature Phillip T. Hansen Title Registered Land Surveyor Registration No. S-498  
(County Surveyor, Registered Land Surveyor, or other duly authorized official)  
Office of Register of Deeds, County of Oneida  
at PO o'clock PM day of August, 1979

I hereby certify that the within instrument was filed in this office for record on the 27th day of August, 1979

By Debra Dinkshaus Deputy

3610192020