

CERTIFIED LAND CORNER RESTORATION


Index No. 0-4

State of Wisconsin

County of Oneida } ss.

I, Philip T. Hansen, do hereby certify that on the 26th day of July, 1979, I found and established the NE 1/16 corner of Section 19, Township 36, North, Range 10, East, Fourth Principal Meridian, as described hereon, and that from this evidence I established a new monument and accessories as described hereon to perpetuate the original location of this corner.

Resident witnesses: Glen Barker, Jim Claffin, Herb Wagoner

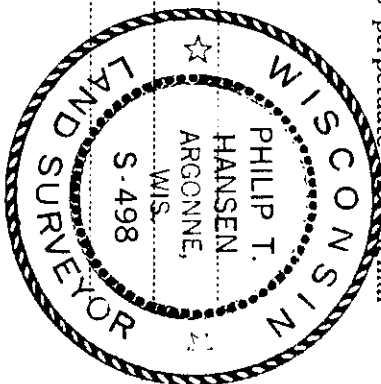


History of original corner establishment: No records of any previous survey.

Description of corner evidence found: No evidence of any corner recovered.

Corner established by traverse and computation. Computed distance from E 1/16 between sections 18 and 19 to EC 1/16 is 2769.379 feet at bearing S 2° 20' 47" W. Computed distance of NE 1/16 is 1384.123' from E 1/16 and 1384.256 feet from EC 1/16.

Description of monument and accessories I established to perpetuate the original location of this corner. Set 1-1/2" iron pipe with 2" brass cap, projecting 24" - stamped:

- Marked NBT's - Red Pine 6" S61°E 7.12 feet, Red Pine 6" S42°W 4.0 feet, scribed 1/16 BT.

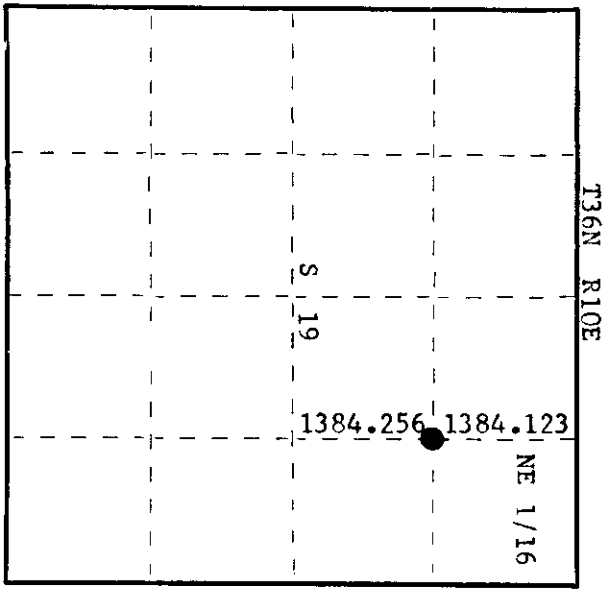

○ = Corner monument restored.

Dated at Rhineland, Wis., this 7th day of August, 1979

Signature: Philip T. Hansen, Registered Land Surveyor, Title: Registered Land Surveyor, Registration No. S-498. Office of Register of Deeds, County of Oneida. Instrument was filed in this office for record on the 27th day of August, 1979 at 10:00 o'clock P.M. I hereby certify that the within

Signature: Dana George Kurlow, (Register of Deeds)

By: Deputy

3610193010